


1 LOCATION OF WATER WELL: COUNTY: 047 KEARNY	Fraction NC SE 1/4	Section Number 27	Township Number T 26 S	Range Number R 35 W
---	-----------------------	----------------------	---------------------------	------------------------

Distance and direction from nearest town or city street address of well if located within city?
FROM DEERFIELD; APPX 14 3/4 MILES SOUTH

2 WATER WELL OWNER: WILLIAM & NANCY SCHULTZ
RR#, St. Address, Box #: 525 S. SANDERS ST
City, State, ZIP code: RIDGE CREST, CA 93555-5015
Board of Agriculture, Division of Water Resources
Application Number: 33,603

3 LOCATE WELL'S LOCATION WITH
AN "X" IN SECTION BOX:

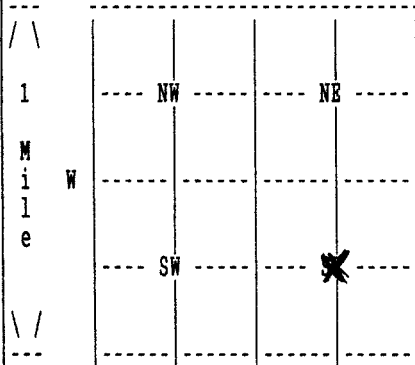

4 DEPTH OF COMPLETED WELL 582 ELEVATION: 0
Depth(s) Groundwater Encountered 1. 0 ft. 2. 0 ft. 3. 0 ft.

WELL'S STATIC WATER LEVEL 296 ft. below land surface measured on mo/day/yr 05/28/05
Pump test data: Well water was 391 ft. after 4 hours pumping 1200 gpm

Estimated Yield 0 gpm: Well water was 0 ft. after 0 hours pumping 0 gpm

Bore Hole Diameter 24 in. to 582 ft., and in. to 0 ft.

WELL WATER TO BE USED AS: 02 IRRIGATION

Was a chemical/bacteriological sample submitted to department? No ;
If yes, mo/day/yr sample was submitted Water well disinfected? Yes

5 TYPE OF BLANK CASING USED: 01 STEEL CASING JOINTS: WELDED
Blank casing diameter 16 in. to 582 ft., Dia in. to 0 ft., Dia in. to 0 ft.
Casing height above land surface 12 in., weight 42 lbs/ft. Wall thickness or gauge No. .250
TYPE OF SCREEN OR PERFORATION MATERIAL: 01 STEEL
SCREEN OR PERFORATION OPENINGS ARE: 01 CONT. SLOT

SCREEN PERFORATED INTERVALS:	From 327 ft. to 577 ft., From 0 ft. to 0 ft.
	From 0 ft. to 0 ft., From 0 ft. to 0 ft.
GRAVEL PACK INTERVALS:	From 20 ft. to 582 ft., From 0 ft. to 0 ft.
	From 0 ft. to 0 ft., From 0 ft. to 0 ft.

6 GROUT MATERIAL 03 BENTONITE
Grout Intervals: From 0 ft. to 20 ft., From 0 ft. to 0 ft., From 0 ft. to 0 ft.
What is the nearest source of possible contamination: 14 ABAND. WELL
Direction from well? SOUTHEAST How many feet? 98

FROM	TO	LITHOLOGIC LOG	FROM	TO	PLUGGING INTERVALS
0	1	05 SAND			
1	39	07 FINE SAND			
39	58	04 SANDY CLAY 07 FINE SAND			
58	120	05 SAND 11 GRAVEL			
120	140	07 FINE SAND 08 MEDIUM SAND 01 CLAY			
140	164	05 SAND 11 GRAVEL			
164	169	01 CLAY			
169	223	05 SAND 11 GRAVEL 01 CLAY			
223	260	01 CLAY 05 SAND 20 LIMESTONE			
260	294	05 SAND 11 GRAVEL 01 CLAY			

7 CONTRACTOR'S OR LANDOWNER'S CERTIFICATION: This water well was Constructed under my jurisdiction and was completed on (mo/day/year) 05/26/05 and this record is true to the best of my knowledge and belief. Kansas Water Well Contractor's License No. 145 This Water Well Record was completed on (mo/day/yr) 08/09/05 under the business name of HENKLE DRILLING & SUPPLY by (signature)

(Continued)

WATER WELL RECORD Form WWC-5 KSA 82a-1212

1 LOCATION OF WATER WELL: COUNTY: 047 KEARNY	Fraction 1/4 NC 1/4 SE 1/4	Section Number 27	Township Number T 26 S	Range Number R 35 W
---	-------------------------------	----------------------	---------------------------	------------------------

2 WATER WELL OWNER: WILLIAM & NANCY SCHULTZ
RR#, St. Address, Box # : 525 S. SANDERS ST
City, State, ZIP code : RIDGE CREST, CA 93555-5015

Board of Agriculture, Division of Water Resources
Application Number: 33,603

FROM	TO	LITHOLOGIC LOG
294	297	01 CLAY
297	318	05 SAND 13 FINE GRAVEL 14 MED GRAVEL
318	322	01 CLAY 20 LIMESTONE
322	334	07 FINE SAND 08 MEDIUM SAND 01 CLAY
334	346	01 CLAY 05 SAND
346	365	07 FINE SAND 01 CLAY
365	373	05 SAND
373	416	01 CLAY 05 SAND
416	430	31 CALICHE 23 SANDSTONE
430	437	23 SANDSTONE 31 CALICHE
447	465	31 CALICHE 23 SANDSTONE
465	500	31 CALICHE 23 SANDSTONE
500	515	23 SANDSTONE
515	530	23 SANDSTONE
530	565	23 SANDSTONE 31 CALICHE
565	577	31 CALICHE 23 SANDSTONE
577	590	19 SHALE 31 CALICHE

7 CONTRACTOR'S OR LANDOWNER'S CERTIFICATION: This water well was Constructed under my jurisdiction and was completed on (mo/day/year) 05/26/05 and this record is true to the best of my knowledge and belief. Kansas
Water Well Contractor's License No. 145 This Water Well Record was completed on (mo/day/yr) 08/09/05
under the business name of HENKLE DRILLING & SUPPLY by (signature)