

1 LOCATION OF WATER WELL:	Fraction	Section Number	Township Number	Range Number
County: Kearny	NE ¼ SW ¼ SW ¼	2	T 26 S	R 36 E W


Distance and direction from nearest town or city street address of well if located within city?

8 3/4 South 1 East of Lakin, KS

2	WATER WELL OWNER:	#6-I Masonic Home	H-30 Drilling	
	RR#, St. Address, Box # :		251 N. Water Ste 10	Board of Agriculture, Division of Water Resources
	City, State, ZIP Code :		Wichita, Ks 67202	Application Number: T89-050

3 LOCATE WELL'S LOCATION WITH AN "X" IN SECTION BOX:

4 DEPTH OF COMPLETED WELL.....200..... ft. ELEVATION:

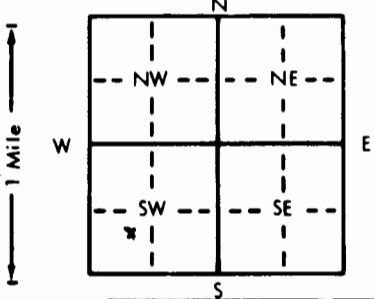

Depth(s) Groundwater Encountered 1. 110 ft. 2. ft. 3. ft.

WELL'S STATIC WATER LEVEL 90 ft. below land surface measured on mo/day/yr 2-7-89

Pump test data: Well water was 105 ft. after 2 hours pumping 60 gpm

Est. Yield 65 gpm: Well water was ft. after hours pumping gpm

Bore Hole Diameter 9 in. to 200 ft., and in. to ft.

WELL WATER TO BE USED AS:

5 Public water supply	8 Air conditioning	11 Injection well		
1 Domestic	3 Feedlot	6 <u>Oil field water supply</u>	9 Dewatering	12 Other (Specify below)
2 Irrigation	4 Industrial	7 Lawn and garden only	10 Monitoring well	

Was a chemical/bacteriological sample submitted to Department? Yes.....No X.....; If yes, mo/day/yr sample was submitted

Water Well Disinfected? Yes X No

5 TYPE OF BLANK CASING USED:

(SR)	5 Wrought iron	8 Concrete tile	CASING JOINTS: Glued . ☒ Clamped
	6 Asbestos-Cement	9 Other (specify below)	Welded
	7 Fiberglass		Threaded.

Blank casing diameter 5 . . . in. to . . . 100 . . . ft., Dia in. to ft., Dia in. to ft.
Casing height above land surface 14 . . . in., weight 200 . . . lbs./ft. Wall thickness or gauge No. 0.265

TYPE OF SCREEN OR PERFORATION MATERIAL:

1 Steel	3 Stainless steel	5 Fiberglass	8 RMP (SR)	11 Other (specify)
2 Brass	4 Galvanized steel	6 Concrete tile	9 ABS	12 None used (open hole)

SCREEN OR PERFORATION OPENINGS ARE:

1 Continuous slot	3 Mill slot	6 Wire wrapped	9 Drilled holes
2 Louvered shutter	4 Key punched	7 Torch cut	10 Other (specify)

SCREEN-PERFORATED INTERVALS: From 100 ft. to 200 ft., From . ft. to . ft.

From ft. to ft., From ft. to ft.

GRAVEL PACK INTERVALS: From 85 ft. to 200 ft., From ft. to ft.

From	ft. to	ft., From	ft. to	ft.
------	--------	-----------	--------	-----

6 GROUT MATERIAL: 1 Neat cement 2 Cement grout 3 Bentonite 4 Other

Grout Intervals: From 0 ft. to 20 ft., From ft. to ft., From ft. to ft.

What is the nearest source of possible contamination

1 Septic tank	4 Lateral lines	7 Pit privy	11 Fuel storage	15 <u>Oil well/Gas well</u>
2 Sewer lines	5 Cess pool	8 Sewage lagoon	12 Fertilizer storage	16 Other (specify below)
3 Watertight sewer lines	6 Seepage pit	9 Feedyard	13 Insecticide storage	

Direction from well?

Southwest

How many feet? 250

[illegible]

7 CONTRACTOR'S OR LANDOWNER'S CERTIFICATION: This water well was (1) constructed, (2) reconstructed, or (3) plugged under my jurisdiction and was

completed on (mo/day/year) 2-7-89 and this record is true to the best of my knowledge and belief. Kansas

Water Well Contractor's License No. 142 This Water Well Record was completed on (mo/day/yr) 2-9-89

under the business name of T & W Water Well Service, Inc. by (signature) CD Wagonella

INSTRUCTIONS: Use typewriter or ball point pen. PLEASE PRESS FIRMLY and PRINT clearly. Please fill in blanks, underline or circle the correct answers. Send top three copies to Kansas Department of Health and Environment, Bureau of Water Protection, Topeka, Kansas 66620-7320. Telephone: 913-296-5514. Send one to WATER WELL OWNER and retain one for your records.