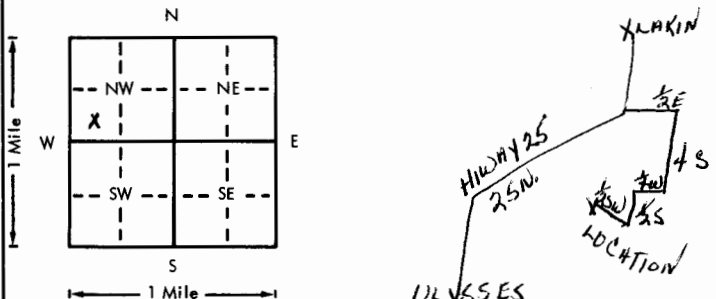


USE TYPEWRITER OR BALL
POINT PEN-PRESS FIRMLY,
PRINT CLEARLY.

WATER WELL RECORD
KSA 82a-1201-1215

Kansas Department of Health and
Environment-Division of Environment
(Water well Contractors)
Topeka, Kansas 66620

Lee A-2

1. Location of well:		County Kearny	Fraction 1/4 SW 1/4 NW 1/4	Section number 4	Township number T 26 S R 36 E/W	Range number
2. Distance and direction from nearest town or city: 24 miles north of Ulysses and about 5 1/2 miles south. Street address of well location if in city:				3. Owner of well: Zenith Drilling Company Rig #6 R.R. or street: Suite 600, 200 W. Douglas City, state, zip code: Wichita, Kansas 67901		
4. Locate with "X" in section below:		Sketch map:		6. Bore hole dia. 9 in. Completion date 12-12-75 Well depth 240 ft.		
				7. <input checked="" type="checkbox"/> Cable tool <input checked="" type="checkbox"/> Rotary <input type="checkbox"/> Driven <input type="checkbox"/> Dug <input type="checkbox"/> Hollow rod <input type="checkbox"/> Jetted <input type="checkbox"/> Bored <input type="checkbox"/> Reverse rotary		
5. Type and color of material		From	To	8. Use: <input type="checkbox"/> Domestic <input type="checkbox"/> Public supply <input type="checkbox"/> Industry <input type="checkbox"/> Irrigation <input type="checkbox"/> Air conditioning <input type="checkbox"/> Stock <input type="checkbox"/> Lawn <input checked="" type="checkbox"/> Oil field water <input type="checkbox"/> Other		
Surface		0	2	9. Casing: Material <input type="checkbox"/> Height: Above or below Threaded <input type="checkbox"/> Welded <input type="checkbox"/> Surface 28 in. RMP <input type="checkbox"/> PVC <input checked="" type="checkbox"/> Weight 2.78 lbs./ft. Dia. 5 in. to 175 ft. depth Wall Thickness: inches or Dia. 5 in. to 240 ft. depth gage No. .265		
Medium to large sand		2	20	10. Screen: Manufacturer's name sawed perf. Type PVC Dia. 5 1/2 Slot/gauze .030 Length 60 Set between 175 ft. and 235 ft. Gravel pack? yes Size range of material 1/8 to 3/16		
Gravel		20	80	11. Static water level: 85 ft. below land surface Date 12-12-75 mo./day/yr.		
Medium to large sand and gravel 70-30		80	240	12. Pumping level below land surfaces: ____ ft. after ____ hrs. pumping ____ g.p.m. ____ ft. after ____ hrs. pumping ____ g.p.m. Estimated maximum yield 50 g.p.m.		
				13. Water sample submitted: ____ mo./day/yr. Yes <input checked="" type="checkbox"/> No <input type="checkbox"/> Date ____		
				14. Well head completion: ____ Pitless adapter 28 inches above grade		
				15. Well grouted? yes With: <input checked="" type="checkbox"/> Neat cement <input type="checkbox"/> Bentonite <input type="checkbox"/> Concrete Depth: From 0 ft. to 10 ft.		
				16. Nearest source of possible contamination: ft. 100 Direction NE Type oilwell Well disinfected upon completion? <input checked="" type="checkbox"/> Yes <input type="checkbox"/> No		
				17. Pump: <input checked="" type="checkbox"/> Not installed Manufacturer's name ____ Model number ____ HP ____ Volts ____ Length of drop pipe ____ ft. capacity ____ g.p.m. Type: <input type="checkbox"/> Submersible <input type="checkbox"/> Turbine <input type="checkbox"/> Jet <input type="checkbox"/> Reciprocating <input type="checkbox"/> Centrifugal <input type="checkbox"/> Other		
18. Elevation:		19. Remarks:		20. Water well contractor's certification: This well was drilled under my jurisdiction and this report is true to the best of my knowledge and belief. Carlile Water Well 118 Business name License No. Address Box 275, Liberal, Ks. Signed Edward E. Means Date 12-18-75 Authorized representative		

Forward the white, blue and pink copies to the Department of Health and Environment

Form WWC-5