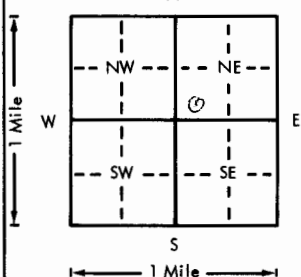


USE TYPEWRITER OR BALL
POINT PEN-PRESS FIRMLY,
PRINT CLEARLY.

WATER WELL RECORD
KSA 82a-1201-1215

Kansas Department of Health and
Environment-Division of Environment
(Water well Contractors)
Topeka, Kansas 66620

Lee B-1

1. Location of well:		County Kearney	Fraction 1/4 SW 1/4 NE 1/4	Section number 9	Township number T 26 S	Range number R 36 E/W
2. Distance and direction from nearest town or city: Ulysses, 6 east, 1 1/2 north, 1/4 west. Street address of well location if in city:			3. Owner of well: Amoco Production R.R. or street: Box 430 City, state, zip code: Ulysses, Kansas 67880			
4. Locate with "X" in section below: 			6. Bore hole dia. 9 in. Completion date 1-29-76 Well depth 240 ft.			
5. Type and color of material			7. <input type="checkbox"/> Cable tool <input checked="" type="checkbox"/> Rotary <input type="checkbox"/> Driven <input type="checkbox"/> Dug <input type="checkbox"/> Hollow rod <input type="checkbox"/> Jetted <input type="checkbox"/> Bored <input type="checkbox"/> Reverse rotary			
Surface			8. Use: <input type="checkbox"/> Domestic <input type="checkbox"/> Public supply <input type="checkbox"/> Industry <input type="checkbox"/> Irrigation <input type="checkbox"/> Air conditioning <input type="checkbox"/> Stock <input type="checkbox"/> Lawn <input checked="" type="checkbox"/> Oil field water <input type="checkbox"/> Other			
Medium to large sand 70-30			9. Casing: Material <input type="checkbox"/> Height: Above or below Threaded <input type="checkbox"/> Welded <input type="checkbox"/> Surface 28 in. RMP <input type="checkbox"/> PVC <input checked="" type="checkbox"/> Weight 2.78 lbs./ft. Dia. 5 in. to 115 ft. depth Wall Thickness: inches or Dia. 5 in. to 240 ft. depth gage No. 265			
Blue and black clay			10. Screen: Manufacturer's name sawed perf. Type PVC Dia. 5 Slot/gauze .030 Length 120 Set between 115 ft. and 235 ft. Gravel pack? yes Size range of material 1/8 to 3/16			
Clay with streaks of sand			11. Static water level: 67 ft. below land surface Date 1-29-76			
Medium to large sand & black sandy clay 70-30			12. Pumping level below land surfaces: ____ ft. after ____ hrs. pumping ____ g.p.m. ____ ft. after ____ hrs. pumping ____ g.p.m. Estimated maximum yield 60 g.p.m.			
			13. Water sample submitted: ____ mo./day/yr. Yes <input checked="" type="checkbox"/> No <input type="checkbox"/> Date ____			
			14. Well head completion: ____ Pitless adapter 28 inches above grade			
			15. Well grouted? yes With <input checked="" type="checkbox"/> Neat cement <input type="checkbox"/> Bentonite <input type="checkbox"/> Concrete Depth: From 0 ft. to 10 ft.			
			16. Nearest source of possible contamination: ft. 100 Direction NE Type Oilwell Well disinfected upon completion? <input checked="" type="checkbox"/> Yes <input type="checkbox"/> No			
			17. Pump: <input checked="" type="checkbox"/> Not installed Manufacturer's name ____ Model number ____ HP ____ Volts ____ Length of drop pipe ____ ft. capacity ____ g.p.m. Type: <input type="checkbox"/> Submersible <input type="checkbox"/> Turbine <input type="checkbox"/> Jet <input type="checkbox"/> Reciprocating <input type="checkbox"/> Centrifugal <input type="checkbox"/> Other			
18. Elevation:			20. Water well contractor's certification: This well was drilled under my jurisdiction and this report is true to the best of my knowledge and belief. Carlile Water Well 118 Business name License No. Address Box 275, Liberal, Kans. Signed Edward E. Means Date 2-6-76 Authorized representative			
19. Remarks:						

Forward the white, blue and pink copies to the Department of Health and Environment

Form WWC-5