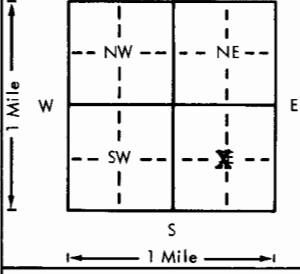


USE TYPEWRITER OR BALL
POINT PEN-PRESS FIRMLY,
PRINT CLEARLY.

WATER WELL RECORD
KSA 82a-1201-1215

Kansas Department of Health and
Environment-Division of Environment
(Water well Contractors)
Topeka, Kansas 66620

1. Location of well:		County Kearny County	Fraction 1/4 1/CSE 1/4	Section number 21	Township number T 26 S.	Range number S R 36 # E/W
2. Distance and direction from nearest town or city: 7 mile South of Lakin on Hiway 25 3/4 mile East 4 mile South Street address of well location if in city: 2 3/4 mile East				3. Owner of well: Earl Berlier R.R. or street: City, state, zip code: Lakin, Kansas 67860		
4. Locate with "X" in section below:		Sketch map:		6. Bore hole dia. 26 in. Completion date 6-30-78 Well depth 350 ft.		
				7. <input type="checkbox"/> Cable tool <input type="checkbox"/> Rotary <input type="checkbox"/> Driven <input type="checkbox"/> Dug <input type="checkbox"/> Hollow rod <input type="checkbox"/> Jetted <input type="checkbox"/> Bored <input checked="" type="checkbox"/> Reverse rotary		
5. Type and color of material		From		To		8. Use: <input type="checkbox"/> Domestic <input type="checkbox"/> Public supply <input type="checkbox"/> Industry <input checked="" type="checkbox"/> Irrigation <input type="checkbox"/> Air conditioning <input type="checkbox"/> Stock <input type="checkbox"/> Lawn <input type="checkbox"/> Oil field water <input type="checkbox"/> Other
						9. Casing: Material Steel Height: Above or below Threaded <input type="checkbox"/> Welded <input checked="" type="checkbox"/> Surface 1 ft. in. RMP <input type="checkbox"/> PVC <input type="checkbox"/> Weight 36.87 lbs./ft. Dia. 16 in. to 350 ft. depth Wall Thickness: inches or Dia. <input type="checkbox"/> in. to <input type="checkbox"/> ft. depth gage No. 219
						10. Screen: Manufacturer's name Johnson Type Johnson Galv. 100 16" Slot/gauze 150-325 Perf ft. Set between 325-345 Screen ft. 345-350 ft Perf ft. Gravel pack? yes Size range of material 1/8 to 5/8
						11. Static water level: <input type="checkbox"/> mo./day/yr. 174 ft. below land surface Date 6-8-78
						12. Pumping level below land surfaces: 182 ft. after 2 hrs. pumping 1125 g.p.m. 189 ft. after 2 hrs. pumping 1700 g.p.m. Estimated maximum yield 1700 g.p.m.
						13. Water sample submitted: <input type="checkbox"/> Yes <input checked="" type="checkbox"/> No Date <input type="checkbox"/>
						14. Well head completion: <input type="checkbox"/> Pitless adapter 1 ft. inches above grade
						15. Well grouted? yes With: <input type="checkbox"/> Neat cement <input type="checkbox"/> Bentonite <input checked="" type="checkbox"/> Concrete Depth: From 0 ft. to 10 ft.
						16. Nearest source of possible contamination: ft. <input type="checkbox"/> Direction N/A Type <input type="checkbox"/> Well disinfected upon completion? <input type="checkbox"/> Yes <input type="checkbox"/> No
						17. Pump: <input type="checkbox"/> Not installed Manufacturer's name Could - 5 stage 12" Model number JHC HP 125 Volts <input type="checkbox"/> Length of drop pipe 240 ft. capacity 800 g.p.m. Type: <input type="checkbox"/> Submersible <input checked="" type="checkbox"/> Turbine <input type="checkbox"/> Jet <input type="checkbox"/> Reciprocating <input type="checkbox"/> Centrifugal <input type="checkbox"/> Other
						(Use a second sheet if needed)
18. Elevation:		19. Remarks:		20. Water well contractor's certification: This well was drilled under my jurisdiction and this report is true to the best of my knowledge and belief. Minter-Wilson Drlg. 208 Business name License No. Address Box A, Garden City, KS Signed <i>[Signature]</i> Date 6-9-78 Authorized representative		
Topography: <input checked="" type="checkbox"/> Hill <input type="checkbox"/> Slope <input type="checkbox"/> Upland <input type="checkbox"/> Valley						

Forward the white, blue and pink copies to the Department of Health and Environment

Form WWC-5

Representative

MINTER-WILSON DRILLING CO.

INCORPORATED

Irrigation
and Domestic
Water Systems
Complete Installation
and Repairing

Phone 276-8069 • P.O. Box 1 • GARDEN CITY, KANSAS 67840

April 13, 1978

Earl Berlier
Kearny County

Location: S. E. $\frac{1}{4}$ 21-26-36

Static Water Level-

Pivot #

0	65	Sand
65	89	Brown Clay
89	236	Med. to coarse gravel (loose)
236	245	Brown Clay
245	265	Blue Clay
265	307	Fine to med. sand and gravel (loose) (streaks of coarse gravel)
317	325	Brown Clay streaks of gravel 30%
325	349	Fine to med. sand and gravel (streaks of coarse gravel (loose)
349	365	Brown Sandy Clay
365	391	Brown Gray Red and Yellow Clay (hard)
391	395	Blue Shale (hard)

T. D. 350