
POINT PEN-PRESS FIRMLY, PRINT CLEARLY.

WATER WELL RECORD KSA 82a-1201-1215

Kansas Department of Health and Environment-Division of Environment (Water well Contractors) Topeka, Kansas 66620

	County Fraction			Section number		Township number		Range n	Range number		
1. Location of well:	Kearny County	1/4	1/4 NE	1/4	2:	2	Т	26 s	R	36	E/W
	25, 6 3/4 East, & location if in city: of Pivot					L		Fletcher KS 67860)		
. Locate with "X" i		Sketch map:					6. Bore ho	ole dia. <u>26</u> in epth 292 ft.	. Completi	on date _3	-28- 79
NW	1 NE						7 Ca	ble tool Rotary	Driv	en Dug	rse rotary
w	E						3	Domestic P Lawn C	ir condition	ning Sto	ock
SW I	SE !						9. Casing: Threaded_	: Material Stee	Height: Surface	Above or b	elow in.
S 1 M							Dia 16_ i	n. to 292 t. dep	oth Wall Th	ickness: inc	hes or
. Type and color of	material				From	То		n. to ft. dep n: Manufacturer's			219
							Type Job	nson Galv	_ D100	-16"	
	Casing Schedu	ما						en	_		ft.
	0 - 150 Pla							ft.	and		5/8
	150 - 210 Per		·		1		Gravel pack. Yes Size range of material 2 to 5/8 11. Static water level: 109 ft. below land surface Date 2-24-79				
	210 - 230 Scr 230 - 270 Pla			<u>-</u>			109	_ft. below land su	rface Date	2-24-	79
270 - 290 Screen 290 - 292 Perf.							12. Pumping level below land surfaces: 116 ft. after hrs. pumping 1200 g.p.m. 119 ft. after hrs. pumping 1500 g.p.m.				
							Estimated	maximum yield —		0	_g.p.m.
M		·					13. Water Yes	sample submitted: X No	Date	mo.	/day/yr.
								nead completion:	ft _Inc	hes above	grade
		,					With:	grouted?	Bentoni ft		Concrete _
•							ft	st source of possibl	N/A	Туре	
							17. Pump:	fected upon comple	Not	Yes _	No
			V				Model nur	100	нр 12		
							Length of Type:			icity1000	
	(Use a second s	heet if needed)					Je	bmersible t entrifugal	_	Turbine Recipro Other	1
8. Elevation:	19. Remarks:				!		20. Water	well contractor's		n:	report
opography:							Minter Business no	the best of my known in Wilson I ame Box A. Gaz		ng Co.	20€ ₹\$ [™] 67€
Slope Upland Valley						1	Address	Authorized rep	Long	se doing	1/29

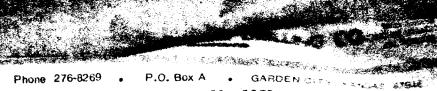

Phone 276-8269 .

January 11, 1979

Walter Fletcher Kearny County

Location: N. E. & 22-26-36 30 North of Pivot Static Water Level - 100 Test #2

ers.		
G B	51	Top Soil Fine Sand
51	97	Fine to med. sand and gravel 10% Clay
97	165	Med. Coarse Gravel
165	230	Coarse Gravel
230	238	Brown Clay
238	246	Brown Sandy Clay small gravel streak
246	271	Brown Sandy Clay
271	289	Fine to med. sand and gravel 10% Clay
289	363	Brown Sandy Clay
363	390	Brown Sandy Clay mixed brown rock hard
390	395	Yellow Clay brown Rock hard pull down

Big Coarse Gravel

RECEIVED

AUG 2 3 1979

DIVISION OF ENVIRONMENT OF & EG SEC.