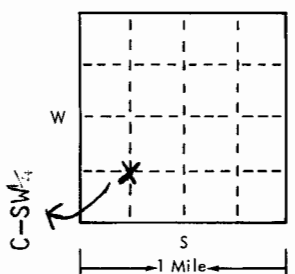
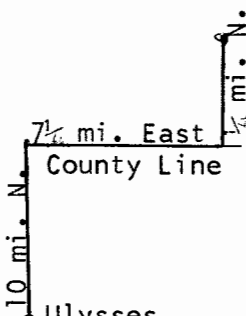


USE TYPEWRITER OR BALL
POINT PEN-PRESS FIRMLY,
PRINT CLEARLY.

WATER WELL RECORD
KSA 82a-1201-1215

T R EW sec 1/4 1/4 1/4 No.

Kansas State Dept. Of Health
(Water Well Contractors)
Forbes-Bldg. 740
Topeka, Kansas 66620

1 Location of well:	County Kearny	Township name	Fraction C-SW$\frac{1}{4}$	Section number 34	Town number T26S	Range number R36W
Distance and direction from nearest town or city: 10 mi. N., 7$\frac{1}{4}$ mi. E., $\frac{1}{4}$ mi. N. of Ulysses Street address of well location if in city:				3 Owner of well: Steve McCormick Address: 103 West Waterman Lakin, Kansas		
Locate with "X" in section below: 				Sketch map: 		
2 Type and color of material				From	To	
Fine Sand				0	15	
" "				15	30	
Medium Sand				30	150	
Coarse Sand & Medium Rock				150	265	
Blue Clay				265	270	
Coarse Sand & Gravel				270	390	
Sandy Clay & Yellow Chalk				390	405	
(use a second sheet if needed)						
4 Well depth: 405 ft. Date of completion 2-15-75 Well diameter 26 in.				5 <input type="checkbox"/> Cable tool <input type="checkbox"/> Rotary <input type="checkbox"/> Driven <input type="checkbox"/> Dug <input type="checkbox"/> Hollow rod <input type="checkbox"/> Jetted <input type="checkbox"/> Bored <input checked="" type="checkbox"/> Reverse rotary		
6 Use: <input type="checkbox"/> Domestic <input type="checkbox"/> Public supply <input type="checkbox"/> Industry <input checked="" type="checkbox"/> Irrigation <input type="checkbox"/> Air conditioning <input type="checkbox"/> Commercial <input type="checkbox"/> Test well <input type="checkbox"/>				7 Casing: Material Steel Height: above/below Threaded <input type="checkbox"/> Welded <input checked="" type="checkbox"/> Surface 12 in. Diam. 16 in. to 247 ft. depth Weight 34 lbs./ft. 18 in. to 405 ft. depth Drive shoe? <input type="checkbox"/> Yes <input checked="" type="checkbox"/> No		
8 Screen: Manufacturer Johnson Type Galvanized Dia. 16" Slot/groove 100X100 Length 20' Set between 227 ft. and 247 ft. Fittings: * See Remarks Gravel pack <input checked="" type="checkbox"/> Yes <input type="checkbox"/> No Size range of material 1/2 down				9 Static water level: 170 ft. below land surface Date 2-18-75		
10 Pumping level below land surfaces: 180 ft. after 6 hrs. pumping 1400 g.p.m. ____ ft. after ____ hrs. pumping ____ g.p.m. Estimated maximum yield 1200 g.p.m.				11 Water sample submitted: <input type="checkbox"/> Yes <input checked="" type="checkbox"/> No Date ____		
12 Well head completion: <input type="checkbox"/> Pitless adapter <input checked="" type="checkbox"/> Inches above grade				13 Well grouted? <input checked="" type="checkbox"/> Yes <input type="checkbox"/> No <input checked="" type="checkbox"/> Neat cement <input type="checkbox"/> Bentonite <input type="checkbox"/> Depth: From 0 ft. to 10 ft.		
14 Nearest source of possible contamination: in field ft. ____ Direction none Type ____ Well disinfected upon completion? <input type="checkbox"/> Yes <input checked="" type="checkbox"/> No				15 Pump: <input type="checkbox"/> Not installed Manufacturer's name Goulds Model number Used HP 150 Volts ____ Length of drop pipe 240 ft. capacity 200 g.m.p. Type: <input type="checkbox"/> Submersible <input checked="" type="checkbox"/> Turbine <input type="checkbox"/> Jet <input type="checkbox"/> Reciprocating <input type="checkbox"/> Centrifugal <input type="checkbox"/> Other		
16 Remarks: elevation Topography: <input checked="" type="checkbox"/> Hill <input type="checkbox"/> Slope <input type="checkbox"/> Upland <input type="checkbox"/> Valley * Lakewood - Perf. - Millslot - .125 X 66 Johnson Screen is 50lbs. per Ft. Lakewood set between 150 & 227 ft. and between 247 & 405				17 Water well contractor's certification: This well was drilled under my jurisdiction and this report is true to the best of my knowledge and belief. K. I. Drilling Co. 263 Business name License No. Address Box 669, Ulysses Kan. Signed Bob Tucker Date 2-18-75 Authorized representative		

Forward the white, blue and pink copies to the Kansas State Dept. Of Health.

Form WWC-5