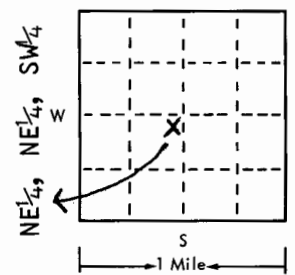
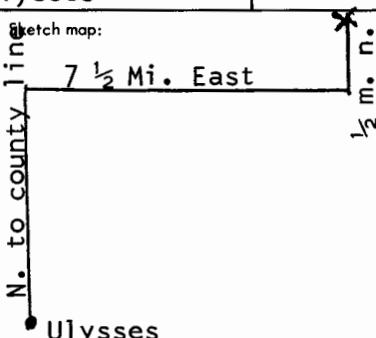


USE TYPEWRITER OR BALL
POINT PEN - PRESS FIRMLY
PRINT CLEARLY.

WATER WELL RECORD
KSA 82a-1201-1215

T R EW sec 1/4 1/4 1/4 No.

Kansas State Dept. Of Health
(Water Well Contractors)
Forbes-Bldg. 740
Topeka, Kansas 66620

1 Location of well:	County Kearny	Township name	Fraction NE$\frac{1}{4}$, NE$\frac{1}{4}$, SW$\frac{1}{4}$	Section number 35	Town number T26S	Range number R36W
Distance and direction from nearest town or city: N. to county line, 7$\frac{1}{2}$ mi. East & $\frac{1}{2}$ mi. N. Street address of well location if in city: From Ulysses				3 Owner of well: Don Phelps Address: Route 1 Ulysses, Kansas 67880		
Locate with "X" in section below: 				Sketch map: 		
2				From	To	
Type and color of material						
Fine Sand				0	60	
Fine Sand & Gyp				60	75	
Medium Sand				75	135	
Sand & Brown Clay				135	150	
Blue Clay				150	195	
Brown Clay & Coarse Sand				195	210	
Coarse Sand				210	315	
Brown Sandy Clay				315	325	
Coarse Sand				325	340	
Brown Clay				340	365	
Coarse Sand, Rock & Clay Strips 80%				365	390	
Coarse Sand, Rock & Clay Strips 50%				390	405	
Fine Blue Shale, Yellow Chalk, Brn. Clay & Sand				405	420	
(use a second sheet if needed)						
16 Remarks: elevation				Drilling Sub-Contracted to: Minter-Wilson Drilling Co. License #208 Garden City, Kansas 67846 * Lakewood - Slot - 125 X 66 Set between 210' & 285', 305' & 370', 390' & 420'		
Topography: ☒ Hill ☐ Slope ☐ Upland ☐ Valley				17 Water well contractor's certification: This well was drilled under my jurisdiction and this report is true to the best of my knowledge and belief. K.I. Drilling Co., Inc. 263 Business name License No. Address P.O. Box 669, Ulysses, Ks. Signed M. Joyce Bunker Date 1-22-76 Authorized representative		

Forward the white, blue and pink copies to the Kansas State Dept. Of Health.

Form WWC-5