


1 LOCATION OF WATER WELL:		Fraction	Section Number			Township Number		Range Number	
County: Kearny		SE 1/4 SW 1/4 NW 1/4	36			T 26 S		R 36 EW	

11 5/8 miles north and 8 east of Ulysses, Kansas

2 WATER WELL OWNER:	Lewis R. Moore	
RR#, St. Address, Box # :	RFD #3	Board of Agriculture, Division of Water Resources
City, State, ZIP Code :	Ulysses, Kansas 67880	Application Number:

3 LOCATE WELL'S LOCATION WITH AN "X" IN SECTION BOX: 4 DEPTH OF COMPLETED WELL... 237 ... ft. ELEVATION: slope ...  
Depth(s) Groundwater Encountered 1. ... 210 ... ft. 2. ... ft. 3. ... ft.

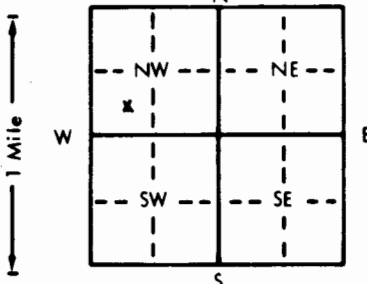

4) DEPTH OF COMPLETED WELL.....237..... ft. ELEVATION: slope.....  
 Depth(s) Groundwater Encountered 1.....210..... ft. 2..... ft. 3..... ft.  
 WELL'S STATIC WATER LEVEL.....210..... ft. below land surface measured on mo/day/yr 5/9/1990.....  
 Pump test data: Well water was.....210..... ft. after.....6..... hours pumping.....5..... gpm  
 Est. Yield.....25..... gpm: Well water was..... ft. after..... hours pumping..... gpm  
 Bore Hole Diameter.....9.3/4..... in. to.....237..... ft., and..... in. to..... ft.  
 WELL WATER TO BE USED AS: 5 Public water supply 8 Air conditioning 11 Injection well  
 ① Domestic 3 Feedlot 6 Oil field water supply 9 Dewatering 12 Other (Specify below)  
 2 Irrigation 4 Industrial 7 Lawn and garden only 10 Monitoring well.....pasture well.....  
 Was a chemical/bacteriological sample submitted to Department? Yes.....No.....x...; If yes, mo/day/yr sample was sub  
 mitted Water Well Disinfected? Yes x No

5	TYPE OF BLANK CASING USED:		5 Wrought iron	8 Concrete tile	CASING JOINTS: Glued <input checked="" type="checkbox"/> ... Clamped <input type="checkbox"/> & Welded <input checked="" type="checkbox"/> riveted <input type="checkbox"/> Threaded <input type="checkbox"/>
	1 Steel	3 RMP (SR)	6 Asbestos-Cement	9 Other (specify below)	
	2 PVC	4 ABS	7 Fiberglass		

Blank casing diameter . . . . . 5 . . . . . in. to . . . . . 207 . . . . . ft., Dia . . . . . in. to . . . . . ft., Dia . . . . . in. to . . . . . ft.  
Casing height above land surface . . . . . 20 . . . . . in., weight . . . . . lbs./ft. Wall thickness or gauge No. schedule . . . . . 250 . . . . .

TYPE OF SCREEN OR PERFORATION MATERIAL:			7 PVC	10 Asbestos-cement	SDR-17
1 Steel	3 Stainless steel	5 Fiberglass	8 RMP (SR)	11 Other (specify) . . . . .	
2 Brass	4 Galvanized steel	6 Concrete tile	9 ABS	12 None used (open hole)	

SCREEN OR PERFORATION OPENINGS ARE:

1 Continuous slot	3 <u>Mill slot</u>	5 Gauzed wrapped	8 Saw cut	11 None (open hole)
2 Louvered shutter	4 <u>Key punched</u>	6 Wire wrapped	9 Drilled holes	
		7 Torch cut	10 Other (specify) .....	

SCREEN-PERFORATED INTERVALS:	From .207	ft. to .237	ft., From	ft. to	ft.
	From	ft. to	ft., From	ft. to	ft.
GRAVEL PACK INTERVALS:	From .237	ft. to .87	ft., From	ft. to	ft.
CLAY	From 87	ft. to 15	ft., From	ft. to	ft.

6 GROUT MATERIAL: 1 Neat cement 2 ~~Cement grout~~ 3 Bentonite 4 Other  
Grout Intervals: From 15 ft. to 0 ft., From ft. to ft., From ft. to ft.

What is the nearest source of possible contamination:			10 Livestock pens	14 Abandoned water well
1 Septic tank	4 Lateral lines	7 Pit privy	11 Fuel storage	15 Oil well/Gas well
2 Sewer lines	5 Cess pool	8 Sewage lagoon	12 Fertilizer storage	16 Other (specify below)
3 Watertight sewer lines	6 Seepage pit	9 Feedyard	13 Insecticide storage	none .. pasture .....

Direction from well? \_\_\_\_\_ How many feet? \_\_\_\_\_

[illegible]

7 CONTRACTOR'S OR LANDOWNER'S CERTIFICATION: This water well was (1) constructed, (2) reconstructed, or (3) plugged under my jurisdiction and was completed on (mo/day/year) ... May 11, 1990 ... and this record is true to the best of my knowledge and belief. Kansas Water Well Contractor's License No. .... ~~166~~ 164 ... This Water Well Record was completed on (mo/day/yr) .. May 30, 1990 ... under the business name of Houck Bros. Drilling Co. by (signature) Gerald Houck