

WATER WELL RECORD Form WWC-5


Original Record Correction Change in Well Use

Division of Water Resources App. No.

Well ID

1 LOCATION OF WATER WELL: County: Kearny Fraction SE 1/4 SW 1/4 SW 1/4 NE 1/4 Section Number 12 Township Number T 26 S Range Number R 36 E W

2 WELL OWNER: Last Name: Fletcher First: Walt Street or Rural Address where well is located (if unknown, distance and direction from nearest town or intersection): If at owner's address, check here:
 Business: Fletcher Ranch, Inc.
 Address: P. O. Box C
 Address:
 City: Lakin State: KS ZIP: 67860
From Lakin - 1 mile South on Hwy 25 to River Road 3/8 mile East.

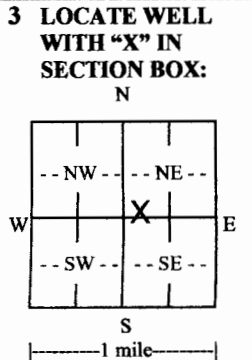

4 DEPTH OF COMPLETED WELL: 330 ft.
 Depth(s) Groundwater Encountered: 1) 200 ft.
 2) ft. 3) ft., or 4) Dry Well
 WELL'S STATIC WATER LEVEL: 200 ft.
 below land surface, measured on (mo-day-yr) 05/20/2017
 above land surface, measured on (mo-day-yr)
 Pump test data: Well water was ft.
 after hours pumping gpm
 Well water was ft.
 after hours pumping gpm
 Estimated Yield: 30 gpm
 Bore Hole Diameter: 10 in. to 330 ft. and
 in. to ft.

5 Latitude: 37.80222 (decimal degrees)
Longitude: 101.20538 (decimal degrees)
 Datum: WGS 84 NAD 83 NAD 27
 Source for Latitude/Longitude:
 GPS (unit make/model:)
 (WAAS enabled? Yes No)
 Land Survey Topographic Map
 Online Mapper:

6 Elevation: 3005 ft. Ground Level TOC
 Source: Land Survey GPS Topographic Map
 Other KOLAR

7 WELL WATER TO BE USED AS:

1. Domestic: <input type="checkbox"/> Household <input type="checkbox"/> Lawn & Garden <input checked="" type="checkbox"/> Livestock	2. <input type="checkbox"/> Irrigation	3. <input type="checkbox"/> Feedlot	4. <input type="checkbox"/> Industrial	5. <input type="checkbox"/> Public Water Supply: well ID	6. <input type="checkbox"/> Dewatering: how many wells?	7. <input type="checkbox"/> Aquifer Recharge: well ID	8. <input type="checkbox"/> Monitoring: well ID	9. Environmental Remediation: well ID <input type="checkbox"/> Air Sparge <input type="checkbox"/> Soil Vapor Extraction <input type="checkbox"/> Recovery <input type="checkbox"/> Injection	10. <input type="checkbox"/> Oil Field Water Supply: lease	11. Test Hole: well ID <input type="checkbox"/> Cased <input type="checkbox"/> Uncased <input type="checkbox"/> Geotechnical	12. Geothermal: how many bores? a) Closed Loop <input type="checkbox"/> Horizontal <input type="checkbox"/> Vertical b) Open Loop <input type="checkbox"/> Surface Discharge <input type="checkbox"/> Inj. of Water	13. <input type="checkbox"/> Other (specify):
---	--	-------------------------------------	--	--	---	---	---	---	--	---	---	---

Was a chemical/bacteriological sample submitted to KDHE? Yes No If yes, date sample was submitted:
 Water well disinfected? Yes No

8 TYPE OF CASING USED: Steel PVC Other CASING JOINTS: Glued Clamped Welded Threaded
 Casing diameter 5 in. to 330 ft., Diameter in. to ft., Diameter in. to ft.
 Casing height above land surface 12 in. Weight lbs./ft. Wall thickness or gauge No. SDR17

TYPE OF SCREEN OR PERFORMANCE MATERIAL:
 Steel Stainless Steel Fiberglass PVC Other (Specify)
 Brass Galvanized Steel Concrete tile None used (open hole)

SCREEN OR PERFORATION OPENINGS ARE:
 Continuous Slot Mill Slot Gauze Wrapped Torch Cut Drilled Holes Other (Specify)
 Louvered Shutter Key Punched Wire Wrapped Saw Cut None (Open Hole)

SCREEN-PERFORATED INTERVALS: From 270 ft. to 330 ft., From ft. to ft., From ft. to ft.
 GRAVEL PACK INTERVALS: From 20 ft. to 330 ft., From ft. to ft., From ft. to ft.

9 GROUT MATERIAL: Neat cement Cement grout Bentonite Other
 Grout Intervals: From 0 ft. to 20 ft., From ft. to ft., From ft. to ft.

Nearest source of possible contamination:
 Septic Tank Lateral Lines Pit Privy Livestock Pens Insecticide Storage
 Sewer Lines Cess Pool Sewage Lagoon Fuel Storage Abandoned Water Well
 Watertight Sewer Lines Seepage Pit Feedyard Fertilizer Storage Oil Well/Gas Well
 Other (Specify)

Direction from well? NW Distance from well? 25 ft.

10 FROM	TO	LITHOLOGIC LOG	FROM	TO	LITHO. LOG (cont.) or PLUGGING INTERVALS
0	10	brown sandy clay	232	257	brown sandy clay
10	45	course sand	257	265	medium sand
45	63	brown sandy clay	265	330	sandstone
63	115	course sand			
115	130	blue clay			
130	205	course sand & brown clay layers			
205	210	blue clay			
210	220	fine sand (tight)			
220	232	fine sand & brown clay layers			

11 CONTRACTOR'S OR LANDOWNER'S CERTIFICATION: This water well was constructed, reconstructed, or plugged under my jurisdiction and was completed on (mo-day-year) 05/20/2017 and this record is true to the best of my knowledge and belief. Kansas Water Well Contractor's License No. 533 This Water Well Record was completed on (mo-day-year) 05/22/2017 under the business name of Jantzen Water Well