WATER WELL RECORD Form WWC-5 KSA 82a-1212

1 LOCATION OF WATER WELL: County: KEARNEY | Fraction: S2 ¼ NW ¼ SW ¼ | Section Number: 14 | Township Number: T 26 S | Range Number: R 37W E/W

Distance and direction from nearest town or city street address of well if located within city?
6 ½ MILES SOUTH HARTLAND, KS

2 WATER WELL OWNER: HELMERICH & PAYNE # B-1 HILLYARD
RR#, St. Address, Box # : BOX 558
City, State, ZIP Code : GARDEN CITY, KS 67846-
Board of Agriculture, Division of Water Resources Application Number: 9501161

3 LOCATE WELL'S LOCATION WITH AN "X" IN SECTION BOX:

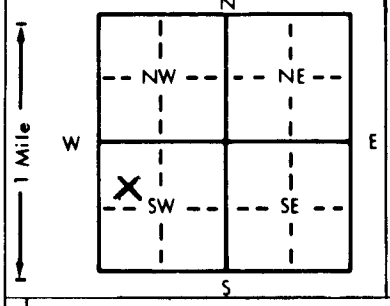

4 DEPTH OF COMPLETED WELL 220 ft. ELEVATION:
Depth(s) Groundwater Encountered 1. 130 ft. 2. ft. 3. ft.
WELL'S STATIC WATER LEVEL 130 ft. below land surface measured on mo/day/yr 5-13-95
Pump test data: Well water was 150 ft. after 1 hours pumping 55 gpm
Est. Yield 55 gpm: Well water was ft. after hours pumping gpm
Bore Hole Diameter 11 in. to 220 ft., and in. to ft.
WELL WATER TO BE USED AS: 5 Public water supply 8 Air conditioning 11 Injection well
1 Domestic 3 Feedlot (6) Oil field water supply 9 Dewatering 12 Other (Specify below)
2 Irrigation 4 Industrial 7 Lawn and garden only 10 Monitoring well
Was a chemical/bacteriological sample submitted to Department? Yes No X; If yes, mo/day/yr sample was submitted
Water Well Disinfected? Yes X No

5 TYPE OF BLANK CASING USED: 5 Wrought iron 8 Concrete tile CASING JOINTS: Glued X Clamped
1 Steel 3 RMP (SR) 6 Asbestos-Cement 9 Other (specify below) Welded
(2) PVC 4 ABS 7 Fiberglass Threaded
Blank casing diameter 6 in. to 220 ft., Dia in. to ft., Dia in. to ft.
Casing height above land surface 24 in., weight 2.902 lbs./ft. Wall thickness or gauge No. .280 SDR 21

TYPE OF SCREEN OR PERFORATION MATERIAL: (7) PVC 10 Asbestos-cement
1 Steel 3 Stainless steel 5 Fiberglass 8 RMP (SR) 11 Other (specify)
2 Brass 4 Galvanized steel 6 Concrete tile 9 ABS 12 None used (open hole)

SCREEN OR PERFORATION OPENINGS ARE: 5 Gauzed wrapped (8) Saw cut 11 None (open hole)
1 Continuous slot 3 Mill slot 6 Wire wrapped 9 Drilled holes
2 Louvered shutter 4 Key punched 7 Torch cut 10 Other (specify)

SCREEN-PERFORATED INTERVALS: From 160 ft. to 220 ft., From ft. to ft.
From ft. to ft., From ft. to ft.
GRAVEL PACK INTERVALS: From 140 ft. to 220 ft., From ft. to ft.
From ft. to ft., From ft. to ft.

6 GROUT MATERIAL: (1) Neat cement 2 Cement grout 3 Bentonite (4) Other HOLE PLUG
Grout Intervals: From 1 ft. to 20 ft., From ft. to ft., From ft. to ft.

What is the nearest source of possible contamination:
1 Septic tank 4 Lateral lines 7 Pit privy 10 Livestock pens 14 Abandoned water well
2 Sewer lines 5 Cess pool 8 Sewage lagoon 11 Fuel storage (15) Oil well/Gas well
3 Watertight sewer lines 6 Seepage pit 9 Feedyard 12 Fertilizer storage 16 Other (specify below)
13 Insecticide storage
Direction from well? Northeast How many feet? 115

FROM	TO	LITHOLOGIC LOG	FROM	TO	PLUGGING INTERVALS
0	2	TOP SOIL			
2	35	SAND			
35	55	SANDY CLAY			
55	71	SAND			
71	90	SANDY CLAY			
90	105	CLAY			
105	118	XXXX SAND & SANDY CLAY			
118	140	SAND W/CLAY STREAKS			
140	160	SAND & SAND STONE			
160	166	SAND STONE			
166	181	SAND & SANDY CLAY			
181	216	SAND			
216	220	BLUE CLAY			

7 CONTRACTOR'S OR LANDOWNER'S CERTIFICATION: This water well was (1) constructed, (2) reconstructed, or (3) plugged under my jurisdiction and was completed on (mo/day/year) 5-13-95 and this record is true to the best of my knowledge and belief. Kansas Water Well Contractor's License No. KWCL-430 This Water Well Record was completed on (mo/day/yr) 5-13-95 under the business name of HOWARD DRLG.CO.BOX 806 BEAVER, OK 73932 by (signature)

INSTRUCTIONS: Use typewriter or ball point pen. *PLEASE PRESS FIRMLY* and *PRINT* clearly. Please fill in blanks, underline or circle the correct answers. Send top three copies to Kansas Department of Health and Environment, Bureau of Water, Topeka, Kansas 66620-0001. Telephone: 913-296-5545. Send one to WATER WELL OWNER and retain one for your records.

OFFICE USE ONLY T R E/W SEC. ¼ ¼ ¼