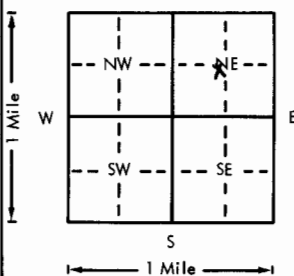
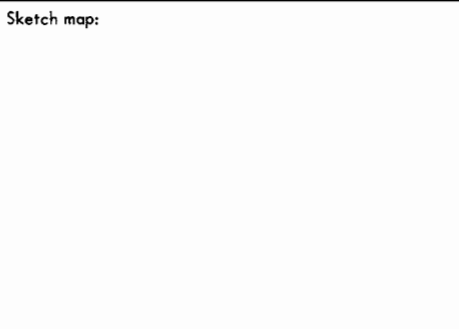


USE TYPEWRITER OR BALL
POINT PEN-PRESS FIRMLY,
PRINT CLEARLY.

WATER WELL RECORD
KSA 82a-1201-1215

Kansas Department of Health and
Environment-Division of Environment
(Water well Contractors)
Topeka, Kansas 66620

1. Location of well:	County Kearny	Fraction NE 1/4 SW 1/4 NE 1/4	Section number 26	Township number T 26 S	Range number R 37	EW
2. Distance and direction from nearest town or city: From Standard Service station at Ulysses, Ks. 12 1/2 north, 1 1/2 east <small>Street address of well location if in city:</small>			3. Owner of well: Leon Shapland R.R. or street: RFD #1 City, state, zip code: Ulysses, Ks. 67880			
4. Locate with "X" in section below: <div style="text-align: center;">  </div>			Sketch map: <div style="text-align: center;">  </div>			
5. Type and color of material			From	To		
Surface			0	2		
Fine sand w/clay breakers			2	79		
Fine to coarse sand w/clay breakers			79	91		
Brown & gray sandy clay w/gravel strips			91	109		
Fine to coarse sand w/clay breakers			109	121		
Brown sandy clay			121	132		
Brown & gray sandy clay, fine sand & sandrock			132	171		
Very fine sand w/clay breakers			171	197		
Fine to medium sand w/gravel strips and clay breakers			197	216		
Medium to coarse sand, gravel strips w/clay breakers			216	241		
Brown sandy clay, very fine sand strips			241	271		
Fine sand strips, medium to coarse sand some good w/clay strips			271	330		
(Use a second sheet if needed)						
18. Elevation:		19. Remarks:				
Topography: <input type="checkbox"/> Hill <input checked="" type="checkbox"/> Slope <input type="checkbox"/> Upland <input type="checkbox"/> Valley		20. Water well contractor's certification: This well was drilled under my jurisdiction and this report is true to the best of my knowledge and belief. Houck Bros. Drilling Co. 164 Business name License No. Address Box 487 Ulysses, Ks. Signed M. Beard Date 5/25/72 Authorized representative				

Forward the white, blue and pink copies to the Department of Health and Environment

Form WWC-5