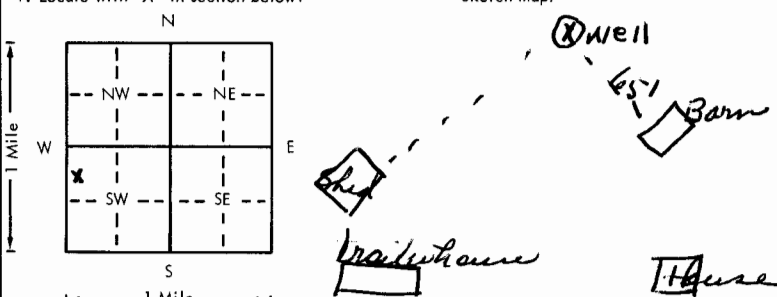


USE TYPEWRITER OR BALL  
POINT PEN-PRESS FIRMLY,  
PRINT CLEARLY.

WATER WELL RECORD  
KSA 82a-1201-1215

Kansas Department of Health and  
Environment-Division of Environment  
(Water well Contractors)  
Topeka, Kansas 66620

1. Location of well: <b>Kearny</b>		Fraction <b>SW 1/4 NW 1/4 SW 1/4</b>		Section number <b>28</b>	Township number <b>26</b>	Range number <b>37</b>
2. Distance and direction from nearest town or city: <b>13 miles north, west, 3/4 south of the four way stop at Ulysses, Ks.</b>				3. Owner of well: <b>Walter Waechter</b> R.R. or street: <b>RFD 3</b> City, state, zip code: <b>Ulysses, Ks. 67880</b>		
4. Locate with "X" in section below:		Sketch map:		6. Bore hole dia. <b>9 1/4</b> in. Completion date <b>1/20/78</b> Well depth <b>230</b> ft.		
				7. Cable tool <input checked="" type="checkbox"/> Rotary <input type="checkbox"/> Driven <input type="checkbox"/> Dug <input type="checkbox"/> Hollow rod <input type="checkbox"/> Jetted <input type="checkbox"/> Bored <input type="checkbox"/> Reverse rotary		
5. Type and color of material		From	To	8. Use: <input type="checkbox"/> Domestic <input type="checkbox"/> Public supply <input type="checkbox"/> Industry <input type="checkbox"/> Irrigation <input type="checkbox"/> Air conditioning <input checked="" type="checkbox"/> Stock <input type="checkbox"/> Lawn <input type="checkbox"/> Oil field water <input type="checkbox"/> Other		
Surface		0	2	9. Casing: Material <b>styrene</b> glued & rivet. (Above or below) Dia. <b>5</b> in. to <b>230</b> ft. depth. Surface <b>18</b> in. RMP <input type="checkbox"/> PVC <input type="checkbox"/> Weight <input type="checkbox"/> lbs./ft. Dia. <input type="checkbox"/> in. to <input type="checkbox"/> ft. depth. Wall Thickness: inches or Dia. <input type="checkbox"/> in. to <input type="checkbox"/> ft. depth. gage No. <b>320</b>		
Sandy clay		2	14	10. Screen: Manufacturer's name <b>Sunflower</b> Type <b>styrene</b> Dia. <b>5"</b> Slot/gauze <b>1/16"</b> Length <b>50</b> Set between <b>180</b> ft. and <b>230</b> ft. Gravel pack? <input checked="" type="checkbox"/> Size range of material <b>1/4"</b>		
Fine to coarse gravel		14	56	11. Static water level: <b>160</b> ft. below land surface Date <b>12/9/77</b>		
Medium to coarse gravel q/clay strips		56	86	12. Pumping level below land surfaces: <b>163</b> ft. after <b>7</b> hrs. pumping <b>15</b> g.p.m. <b>163</b> ft. after <b>7</b> hrs. pumping <b>15</b> g.p.m. Estimated maximum yield <b>20</b> g.p.m.		
Brown sandy clay w/lime shells		86	137	13. Water sample submitted: <input checked="" type="checkbox"/> Yes <input type="checkbox"/> No Date <b>12/9/77</b>		
Fine to medium brown sandy w/clay strips		137	172	14. Well head completion: <input checked="" type="checkbox"/> Pitless adapter <b>18</b> inches above grade		
Dakota sandstone tight		172	188	15. Well grouted? <input checked="" type="checkbox"/> With: <input checked="" type="checkbox"/> Neat cement <input type="checkbox"/> Bentonite <input type="checkbox"/> Concrete Depth: From <b>0</b> ft. to <b>10</b> ft.		
Red sandstone loose		188	190	16. Nearest source of possible contamination: ft. <b>65</b> Direction <b>south</b> Type <b>barn</b> Well disinfected upon completion? <input checked="" type="checkbox"/> Yes <input type="checkbox"/> No		
Red sandstone medium tight		190	193	17. Pump: <input checked="" type="checkbox"/> Not installed Manufacturer's name <b>Houck Bros. Drilling Co.</b> Model number <b>Box 487, Ulysses, Ks.</b> HP <b>164</b> Volts <b>115</b> Length of drop pipe <b>3/4</b> ft. capacity <b>1/4</b> g.p.m. Type: <input type="checkbox"/> Submersible <input type="checkbox"/> Turbine <input type="checkbox"/> Jet <input type="checkbox"/> Reciprocating <input type="checkbox"/> Centrifugal <input type="checkbox"/> Other		
Tight sandstone w/shale strips		193	220	20. Water well contractor's certification: This well was drilled under my jurisdiction and this report is true to the best of my knowledge and belief. <b>Houck Bros. Drilling Co. 164</b> Business <b>Box 487, Ulysses, Ks.</b> License No. <b>3/20/78</b> Address <b>M. Beard</b> Signed <b>M. Beard</b> Authorized representative Date <b>3/20/78</b>		
Sandstone w/ shale strips		220	230			
18. Elevation:		19. Remarks: <b>3053 (TUPO)</b>				
Topography: <input type="checkbox"/> Hill <input checked="" type="checkbox"/> Slope <input type="checkbox"/> Upland <input type="checkbox"/> Valley						

Forward the white, blue and pink copies to the Department of Health and Environment

Form WWC-5