WATER WELL RECORD Form WWC-5 KSA 82a-1212

1 LOCATION OF WATER WELL: County: Hamilton | Fraction: NE ¼ NE ¼ NE ¼ | Section Number: 9 | Township Number: T 26 S | Range Number: R 39 E/W

Distance and direction from nearest town or city street address of well if located within city?
12 South of Kendal

2 WATER WELL OWNER: Jerome Lampe
RR#, St. Address, Box # : Route 1 Box 55
City, State, ZIP Code : Kendal, KS 67857
Board of Agriculture, Division of Water Resources
Application Number:

3 LOCATE WELL'S LOCATION WITH AN "X" IN SECTION BOX:

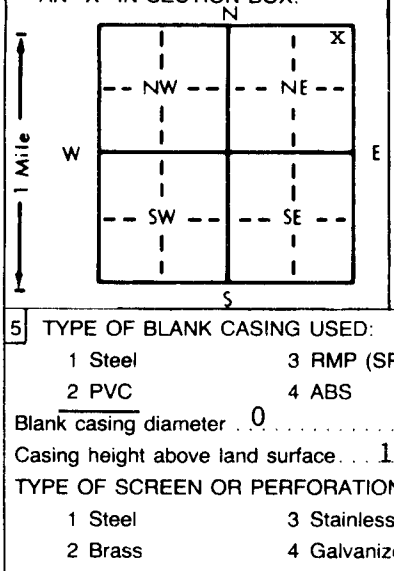

4 DEPTH OF COMPLETED WELL 500 ft. ELEVATION:
Depth(s) Groundwater Encountered 1. 240 ft. 2. ft. 3. ft.
WELL'S STATIC WATER LEVEL 240 ft. below land surface measured on mo/day/yr June 19,95
Pump test data: Well water was 455 ft. after 72 hours pumping 13 gpm
Est. Yield 18 gpm: Well water was ft. after hours pumping gpm
Bore Hole Diameter 9½ in. to ft., and in. to ft.
WELL WATER TO BE USED AS: 1 Domestic 2 Irrigation 3 Feedlot 4 Industrial 5 Public water supply 6 Oil field water supply 7 Lawn and garden only 8 Air conditioning 9 Dewatering 10 Monitoring well 11 Injection well 12 Other (Specify below)
Was a chemical/bacteriological sample submitted to Department? Yes No X; If yes, mo/day/yr sample was submitted
Water Well Disinfected? Yes X No

5 TYPE OF BLANK CASING USED: 1 Steel 2 PVC 3 RMP (SR) 4 ABS 5 Wrought iron 6 Asbestos-Cement 7 Fiberglass 8 Concrete tile 9 Other (specify below)
CASING JOINTS: Glued X Clamped Welded Threaded
Blank casing diameter 0 in. to 320 ft., Dia 5 in. to 340 to 440 ft., Dia in. to ft.
Casing height above land surface 12" in., weight lbs./ft. Wall thickness or gauge No. SDR 26

TYPE OF SCREEN OR PERFORATION MATERIAL: 1 Steel 2 Brass 3 Stainless steel 4 Galvanized steel 5 Fiberglass 6 Concrete tile 7 PVC 8 RMP (SR) 9 ABS 10 Asbestos-cement 11 Other (specify) 12 None used (open hole)
SCREEN OR PERFORATION OPENINGS ARE: 1 Continuous slot 2 Louvered shutter 3 Mill slot 4 Key punched 5 Gauzed wrapped 6 Wire wrapped 7 Torch cut 8 Saw cut 9 Drilled holes 10 Other (specify) 11 None (open hole)

SCREEN-PERFORATED INTERVALS: From 320 ft. to 340 ft., From ft. to ft.
From 440 ft. to 500 ft., From ft. to ft.
GRAVEL PACK INTERVALS: From 25 ft. to 55 ft., From 75 ft. to 500 ft.
From ft. to ft., From ft. to ft.

6 GROUT MATERIAL: 1 Neat cement 2 Cement grout 3 Bentonite 4 Other
Grout Intervals: From 0 ft. to 25 ft., From 55 ft. to 75 ft., From ft. to ft.

What is the nearest source of possible contamination:
1 Septic tank 2 Sewer lines 3 Watertight sewer lines 4 Lateral lines 5 Cess pool 6 Seepage pit 7 Pit privy 8 Sewage lagoon 9 Feedyard 10 Livestock pens 11 Fuel storage 12 Fertilizer storage 13 Insecticide storage 14 Abandoned water well 15 Oil well/Gas well 16 Other (specify below)
Direction from well? East
How many feet? 15'

FROM	TO	LITHOLOGIC LOG	FROM	TO	PLUGGING INTERVALS
0	32	Top Soil and Sandy Clay	229	246	Shale(gray)10% Sandstone
32	49	Sandy Clay	246	295	Gray Shale
49	53	Sand & Gravel	295	311	Gray Shale & 4' Sandstone
53	65	Cemented Sand(hrd),Lt Clay	311	328	Blue Shale
65	98	Sandy Clay	328	344	Blue Shale & 10% Sandstone 2
98	114	Sand & Clay Streaks	344	410	Blue Shale
114	130	Sand & 2' Clay (med)	410	440	Blue Shale & 4' Sandstone
130	137	Cemented Sand(hard)	440	485	White Clay & 10% Sandstone
137	144	Clay	485	515	Sandstone
144	147	Cemented Sand(hard)	515	520	Blue Shale
147	164	Cemented Sand(hrd), Clay Streaks			
164	180	Shale, Lt. Clay Blue			
180	196	Shale, Lt. Clay(hrd)Blue			
196	213	Shale(hrd)blue			
213	229	Gray Shale			

7 CONTRACTOR'S OR LANDOWNER'S CERTIFICATION: This water well was (1) constructed, (2) reconstructed, or (3) plugged under my jurisdiction and was completed on (mo/day/year) June 19, 95 and this record is true to the best of my knowledge and belief. Kansas Water Well Contractor's License No. 473 This Water Well Record was completed on (mo/day/yr) June 20, 95 under the business name of Tyler Water Well Service by (signature)

INSTRUCTIONS: Use typewriter or ball point pen. *PLEASE PRESS FIRMLY* and *PRINT* clearly. Please fill in blanks, underline or circle the correct answers. Send top three copies to Kansas Department of Health and Environment, Bureau of Water, Topeka, Kansas 66620-0001. Telephone: 913-296-5545. Send one to WATER WELL OWNER and retain one for your records.

OFFICE USE ONLY T R E/W SEC. ¼ ¼ ¼