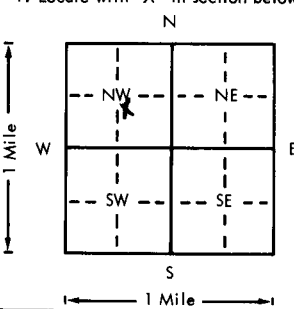


USE TYPEWRITER OR BALL
POINT PEN-PRESS FIRMLY,
PRINT CLEARLY.

WATER WELL RECORD
KSA 82a-1201-1215

Kansas Department of Health and
Environment-Division of Environment
(Water well Contractors)
Topeka, Kansas 66620

1. Location of well:		County Hamilton	Fraction NW 1/4 SE 1/4 NW 1/4	Section number 26	Township number T 26 S R 39	Range number E 1
2. Distance and direction from nearest town or city:		from Standard Service station at Ulysses--11 miles west, 12 1/2 north 1/4 east, then north				
3. Name of owner of well:		Herb Klassen				
Street address of well location if in city:		RFD 1				
City, state, zip code:		Kendall, Ks. 67857				
4. Locate with "X" in section below:		Sketch map:				
						
5. Type and color of material		From	To	6. Bore hole dia. 9 3/4" Completion date 3/12/79		
Surface		0	2	Well depth 255 ft.		
Sandy clay w/sand strips		2	38	7. <input checked="" type="checkbox"/> Cable tool <input checked="" type="checkbox"/> Rotary <input type="checkbox"/> Driven <input type="checkbox"/> Dug <input type="checkbox"/> Hollow rod <input type="checkbox"/> Jetted <input type="checkbox"/> Bored <input type="checkbox"/> Reverse rotary		
Yellow chalk w/white & blue rock		38	85	8. Use: <input type="checkbox"/> Domestic <input type="checkbox"/> Public supply <input type="checkbox"/> Industry <input type="checkbox"/> Irrigation <input type="checkbox"/> Air conditioning <input checked="" type="checkbox"/> Stock <input type="checkbox"/> Lawn <input type="checkbox"/> Oil field water <input type="checkbox"/> Other		
Yellow chalk and blue shale		85	125	9. Casing: Material styrene <input checked="" type="checkbox"/> Above or below <input checked="" type="checkbox"/> Threaded & riveted <input type="checkbox"/> Surface 18 in. RMP 5 <input type="checkbox"/> PVC <input type="checkbox"/> Weight 215 lbs./ft. Dia. 5 in. to 215 ft. depth Wall Thickness: inches or Dia. 5 in. to 215 ft. depth Gage No. 320		
Blue shale & rock layers hard		125	185	10. Screen: Manufacturer's name Sunflower Type styrene Dia. 5" Slot/gauze 1/16" Length 40 Set between 215 ft. and 255 ft. Gravel pack? <input checked="" type="checkbox"/> Size range of material 1/4"		
Shale & sandstone takes water 50%		185	201	11. Static water level: 155 ft. below land surface Date 3/7/79		
Shale & sandstone (lost circulation)		201	206	12. Pumping level below land surfaces: 165 ft. after 4 hrs. pumping 5 g.p.m. ft. after hrs. pumping g.p.m. Estimated maximum yield 50 g.p.m.		
Shale & sandstone 15%		206	225	13. Water sample submitted: X Yes X No Date		
Shale & rock small sandstone strips		225	255	14. Well head completion: 18 inches above grade <input type="checkbox"/> Pitless adapter		
Rock very hard		255	259	15. Well grouted? <input checked="" type="checkbox"/> X With: <input checked="" type="checkbox"/> Neat cement <input type="checkbox"/> Bentonite <input type="checkbox"/> Concrete Depth: From 0 ft. to 10 ft.		
Shale w/some sandstone		259	300	16. Nearest source of possible contamination: field ft. Direction Type field Well disinfected upon completion? X Yes X No		
(Use a second sheet if needed)				17. Pump: X Not installed Manufacturer's name Model number HP Volts Length of drop pipe ft. capacity g.p.m. Type: <input type="checkbox"/> Submersible <input type="checkbox"/> Turbine <input type="checkbox"/> Jet <input type="checkbox"/> Reciprocating <input type="checkbox"/> Centrifugal <input type="checkbox"/> Other		
18. Elevation:		19. Remarks:		20. Water well contractor's certification: This well was drilled under my jurisdiction and this report is true to the best of my knowledge and belief. Houck Bros. Drlg. Co. 164 Business name Box 487, Ulysses, Ks. License No. Address M. Beard Date 8/22/79 Signed M. Beard Authorized representative		