


1 LOCATION OF WATER WELL:		Fraction	Section Number		Township Number		Range Number	
County	Range	SE ¼ SE ¼ SW ¼	16	T 26 S	R 4 E/W			

Distance and direction from nearest town or city street address of well if located within city?

7 West. 1 So. 3/4 Miles From ANDALE, Kans.

2	WATER WELL OWNER: Nancy Schmidt	
	RR#, St. Address, Box # : 12917 E. Silver Lake RD.	Board of Agriculture, Division of Water Resources
	City, State, ZIP Code : Mt Hope, Kansas Kans 67108	Application Number:

3 LOCATE WELL'S LOCATION WITH AN "X" IN SECTION BOX: 4 DEPTH OF COMPLETED WELL... 95' ft. ELEVATION:
 5 10' 20' 30' 

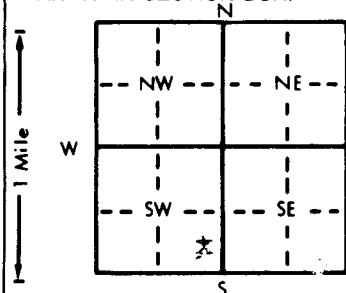

4 DEPTH OF COMPLETED WELL 95' ft. ELEVATION: _____
 Depth(s) Groundwater Encountered 1. 40' ft. 2. _____ ft. 3. _____ ft.
 WELL'S STATIC WATER LEVEL 38' ft. below land surface measured on mo/day/yr Dec. 10th 1998

Pump test data: Well water was ft. after hours pumping gpm
 Est. Yield .25 gpm: Well water was NA ft. after hours pumping gpm
 Bore Hole Diameter .8 1/2" in. to 95' ft., and in. to ft.

WELL WATER TO BE USED AS:

1 Domestic XXXX	3 Feedlot	5 Public water supply	8 Air conditioning	11 Injection well
2 Irrigation	4 Industrial	6 Oil field water supply	9 Dewatering	12 Other (Specify below)
		7 Lawn and garden only	10 Monitoring well	

Was a chemical/bacteriological sample submitted to Department? Yes.....No ~~XX~~.....; If yes, mo/day/yr sample was submitted
Water Well Disinfected? Yes ~~XX~~ No

5	TYPE OF BLANK CASING USED:		5 Wrought iron	8 Concrete tile	CASING JOINTS: Glued . . . Σ . Clamped . . . Welded . . . Threaded . . .
	1 Steel	3 RMP (SR)	6 Asbestos-Cement	9 Other (specify below)	
	2 PVC	4 ABS	7 Fiberglass		

Blank casing diameter . . 5" in. to . 81' ft., Dia in. to ft., Dia in. to ft.
Casing height above land surface . . 14" in. weight . . 2.355 lbs./ft. Wall thickness or gauge No. . 2.14

TYPE OF SCREEN OR PERFORATION MATERIAL:			7 PVC ☒	10 Asbestos-cement
1 Steel	3 Stainless steel	5 Fiberglass	8 RMP (SR)	11 Other (specify)
2 Brass	4 Galvanized steel	6 Concrete tile	9 ABS	12 None used (open hole)

SCREEN OR PERFORATION OPENINGS ARE:			5 Gauzed wrapped	8 Saw cut	11 None (open hole)
1 Continuous slot	3 Mill slot		6 Wire wrapped	9 Drilled holes	
2 Louvered shutter	4 Key punched		7 Torch cut	10 Other (specify)	

SCREEN-PERFORATED INTERVALS:	From 95 ft. to 81' ft.,	From ft. to ft.
	From ft. to ft.,	From ft. to ft.
GRAVEL PACK INTERVALS:	From 95' ft. to 31' ft.,	From ft. to ft.
	From ft. to ft.	From ft. to ft.

6	GROUT MATERIAL:		1 Neat cement	2 Cement grout	XX 3 Bentonite	4 Other
	Grout Intervals:	From 31'	ft to 4'	ft	From	ft to

What is the nearest source of possible contamination:			10 Livestock pens	14 Abandoned water well
1 Septic tank	4 Lateral lines	7 Pit privy	11 Fuel storage	15 Oil well/Gas well
2 Sewer lines	5 Cess pool	8 Sewage lagoon	12 Fertilizer storage	16 Other (specify below)
3 Watertight sewer lines	6 Seepage pit	9 Feedyard	13 Insecticide storage	

Direction from well? S 60° E How many feet? 600'

[illegible]

7 CONTRACTOR'S OR LANDOWNER'S CERTIFICATION: This water well was (1) constructed, (2) reconstructed, or (3) plugged under my jurisdiction and was completed on (mo/day/year) Dec 10th 1998 and this record is true to the best of my knowledge and belief. Kansas Water Well Contractor's License No. 112 ~~555~~ This Water Well Record was completed on (mo/day/yr) Dec. 29 1998 under the business name of Wells Drilling Co. by (signature) Dal Wells