

1	LOCATION OF WATER WELL:	Fraction	Section Number	Township Number	Range Number
County:	PEND	NE $\frac{1}{4}$ SW $\frac{1}{4}$ NE $\frac{1}{4}$	24	T 26 S	R 4 E (W)

Distance and direction from nearest town or city street address of well if located within city?


24207 S. LANDOM CHENEY KS

2 WATER WELL OWNER: LARRY GILCREST
RR#, St. Address, Box # : 24267 S. RANDOM
City, State, ZIP Code : CHENEY, IN

Board of Agriculture, Division of Water Resources
Application Number:

3	LOCATE WELL'S LOCATION WITH	4	DEPTH OF COMPLETED WELL 80 ft. ELEVATION:
---	-----------------------------	---	---

AN "X" IN SECTION BOX:

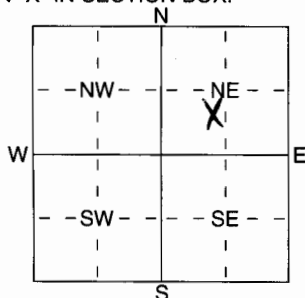

Depth(s) Groundwater Encountered ft. 2 ft. 3 ft.
WELL'S STATIC WATER LEVEL 13 ft. below land surface measured on mo/day/yr
Pump test data: Well water was ft. after hours pumping gpm
Est. Yield 20 gpm: Well water was ft. after hours pumping gpm
WELL WATER TO BE USED AS:

1 Domestic	3 Feedlot	5 Public water supply	8 Air conditioning	11 Injection well
2 Irrigation	4 Industrial	6 Oil field water supply	9 Dewatering	12 Other (Specify below)
		7 Domestic (lawn & garden)	10 Monitoring well	

Was a chemical/bacteriological sample submitted to Department? Yes No X If yes, mo/day/yr sample was submitted

5	TYPE OF BLANK CASING USED:
---	----------------------------

5 Wrought iron
6 Asbestos-Cement
7 Fiberglass

8 Concrete tile
9 Other (specify below)

CASING JOINTS: Glued ☒ Clamped
Welded
Threaded

Blank casing diameter 5 1/2 in. to 20 ft., Dia 3 in. to 10 ft., Dia 10 in. to 12 ft.

Casing height above land surface 13 in., weight 2-40 lbs./ft. Wall thickness or gauge No. 160 PSI

TYPE OF SCREEN OR PERFORATION MATERIAL:

1 Steel	3 Stainless Steel	5 Fiberglass
2 Brass	4 Galvanized Steel	6 Concrete tile

7 PVC
8 RMP (SR)
9 ABS
10 Asbestos-Cement
11 Other (Specify)
12 None used (open hole)

SCREEN OR PERFORATION OPENINGS ARE:

1 Continuous slot
2 Louvered shutter
3 Mill slot
4 Key punched

5 Guazed wrapped
6 Wire wrapped
7 Torch cut

8 Saw cut
9 Drilled holes
10 Other (specify) ft.

SCREEN-PERFORATED INTERVALS: From 20 ft. to 80 ft., From _____ ft. to _____ ft.

From ft. to ft., From ft. to ft.

GRAVEL PACK INTERVALS: From 32 ft. to 80 ft. From _____ ft. to _____ ft.
From _____ ft. to _____ ft. From _____ ft. to _____ ft.

From ft. to ft., From ft. to ft.

6	GROUT MATERIAL:	1 Neat cement	2 Cement grout	3 Bentonite
---	-----------------	---------------	----------------	-------------

Grout Intervals: From 3 ft. to 20 ft., From _____ ft. to _____ ft., From _____ ft. to _____ ft.

What is the nearest source of possible contamination:

1 Septic tank 4 Lateral lines
2 Sewer lines 5 Cess pool
3 Watertight sewer lines 6 Seepage pit

7 Pit privy
8 Sewage lagoon
9 Feedyard

10 Livestock pens	14 Abandoned water well
11 Fuel storage	15 Oil well/Gas well
12 Fertilizer storage	16 Other (specify below)
13 Insecticide storage	

Direction from well?

How many feet? 100

FROM	TO	LITHOLOGIC LOG
------	----	----------------

FROM	TO	PLUGGING INTERVAL S
------	----	---------------------

0	1	701	5011
---	---	-----	------

1	4	FINE SAND
---	---	-----------

4	80	SITALE
---	----	--------

7 CONTRACTOR'S OR LANDOWNER'S CERTIFICATION: This water well was (1) constructed, (2) reconstructed, or (3) plugged under my jurisdiction and was completed on (mo/day/year) 7-12-95 and this record is true to the best of my knowledge and belief. Kansas Water Well Contractor's Licence No. 740 This Water Well Record was completed on (mo/day/yr) 8-12-95 under the business name of WENNER DRILLING INC. by (signature) [Signature]