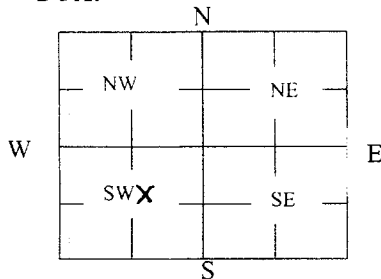


WATER WELL PLUGGING RECORD Form WWC-5P

KSA 82a-1212 ID NO.

ASOBW-1

1 LOCATION OF WATER WELL: County: Reno	Fraction SE ¼ SW ¼ NE ¼ SW ¼	Section Number 8	Township Number T 26 S	Range Number 4 ☐ E ☒ W
Street/Rural Address of Well Location; if unknown, distance & direction from nearest town or intersection: If at owner's address, check here ☐ 4th & Washington Street Scandia, KS		Global Positioning Systems (GPS) information: Latitude: _____ (in decimal degrees) Longitude: _____ (in decimal degrees) Elevation: _____ Horizontal Datum: ☐ WGS84, ☐ NAD83, ☐ NAD27 Collection Method: _____ ☐ GPS unit (Make/Model: _____) ☐ Digital Map/Photo, ☐ Topographic Map, ☐ Land Survey Est. Accuracy: ☐ < 3 m, ☐ 3-5 m, ☐ 5-15 m, ☐ > 15 m		
2 WATER WELL OWNER: Coranco Great Plains, Inc. RR#, St. Address, Box #: 141 W. 10th City, State ZIP Code: Wahoo, NE 68066				

3 MARK WELL'S LOCATION WITH AN "X" IN SECTION BOX:

4 DEPTH OF WELL 25 ft.

WELL'S STATIC WATER LEVEL _____ ft

WELL WAS USED AS:

- | | | |
|-------------------------------------|---|--|
| ☐ Domestic | ☐ Public Water Supply | ☐ Dewatering |
| ☐ Irrigation | ☐ Oil Field Water Supply | ☒ Monitoring |
| ☐ Feedlot | ☐ Domestic (Lawn & Garden) | ☐ Injection Well |
| ☐ Industrial | ☐ Air Conditioning | ☐ Other _____ |

Was a chemical/bacteriological sample submitted to Department? Yes ☐ No ☐
5 TYPE OF BLANK CASING USED:

- | | | | | |
|---|-----------------------------------|--|--|--|
| ☒ Steel | ☐ RMP (SR) | ☐ Wrought | ☐ Fiberglass | ☐ Other (Specify below) _____ |
| ☒ PVC | ☐ ABS | ☐ Asbestos-Cement | ☐ Concrete Tile | |

 Blank casing diameter 2 in. Was casing pulled? Yes ☒ No ☐ If yes, how much ~3ft. below ground surface
 Casing height above or below land surface _____ in.

6 GROUT PLUG MATERIAL:

- ☐
- Neat cement
- ☐
- Cement grout
- ☒
- Bentonite
- ☐
- Other _____

Grout Plug Intervals: From 3 ft. to 25 ft., From _____ ft. to _____ ft., From _____ ft. to _____ ft.

What is the nearest source of possible contamination:

- | | | | |
|---|---|---|--|
| ☐ Septic tank | ☐ Seepage pit | ☐ Fuel storage | ☐ Other (specify below) _____ |
| ☐ Sewer lines | ☐ Pit privy | ☐ Fertilizer storage | |
| ☐ Watertight sewer lines | ☐ Sewage lagoon | ☐ Insecticide storage | |
| ☐ Lateral lines | ☐ Feedyard | ☐ Abandoned water well | Direction from well? _____ |
| ☐ Cess pool | ☐ Livestock pens | ☐ Oil well/Gas well | How many feet? _____ |

FROM	TO	PLUGGING MATERIALS	FROM	TO	PLUGGING MATERIALS
3	25	Bentonite			

7 CONTRACTOR'S OR LANDOWNER'S CERTIFICATION: This water well was plugged under my jurisdiction and was completed on (mo/day/year) 5/7/2018 and this record is true to the best of my knowledge and belief. Kansas Water Well Contractor's License No. N/A. This Water Well Record was completed on (mo/day/year) 8/1/2018 under the business name of GreenField Contractors, Inc. by (signature) Melise D. Melrose

Send one white copy to Kansas Department of Health & Environment, Geology Section, 1000 SW Jackson Street, Ste. 420, Topeka, KS 66612-1367. Send one copy to WATER WELL OWNER and retain one for your records.

 Visit us at <http://www.kdheks.gov/waterwell/index.html> Telephone 785-296-5524.