

1 LOCATION OF WATER WELL: County: Renov Fraction SE 1/4 SE 1/4 SW 1/4 Section Number 20 Township Number T 20 S Range Number R 4 E

Distance and direction from nearest town or city street address of well if located within city?

1 S. 1/2 E of Andah-Haven Rd Intersection

2 WATER WELL OWNER:


RR#, St. Address, Box # :

Board of Agriculture, Division of Water Resources

City, State, ZIP Code :

Application Number:

3 LOCATE WELL'S LOCATION WITH AN "X" IN SECTION BOX:

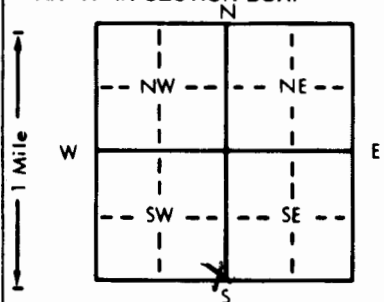

4 DEPTH OF COMPLETED WELL: 70 ft. ELEVATION:

Depth(s) Groundwater Encountered 1. 50 ft. 2. 50 ft. 3. 1-29-89 ft.

WELL'S STATIC WATER LEVEL 50 ft. below land surface measured on mo/day/yr 1-29-89

Pump test data: Well water was 50 ft. after 2 hours pumping 20 gpm

Est. Yield 20+ gpm: Well water was 50 ft. after 2 hours pumping 20 gpm

Bore Hole Diameter 9 in. to 20 ft., and 5 in. to 70 ft.

WELL WATER TO BE USED AS: 5 Public water supply 8 Air conditioning 11 Injection well

1 Domestic 3 Feedlot 6 Oil field water supply 9 Dewatering 12 Other (Specify below)

2 Irrigation 4 Industrial 7 Lawn and garden only 10 Monitoring well

Was a chemical/bacteriological sample submitted to Department? Yes No; If yes, mo/day/yr sample was submitted

Water Well Disinfected? Yes No No

5 TYPE OF BLANK CASING USED:

1 Steel 3 RMP (SR) 5 Wrought iron 8 Concrete tile CASING JOINTS Glued Clamped

2 PVC 4 ABS 6 Asbestos-Cement 9 Other (specify below) Welded

Blank casing diameter 5 in. to 20 ft., Dia. 14 in. to 160 lbs./ft. Wall thickness or gauge No.

Casing height above land surface 14 in., weight 160 lbs./ft.

TYPE OF SCREEN OR PERFORATION MATERIAL: 7 PVC 10 Asbestos-cement

1 Steel 3 Stainless steel 5 Fiberglass 8 RMP (SR) 11 Other (specify)

2 Brass 4 Galvanized steel 6 Concrete tile 9 ABS 12 None used (open hole)

SCREEN OR PERFORATION OPENINGS ARE: 5 Gauzed wrapped 8 Saw cut 11 None (open hole)

1 Continuous slot 3 Mill slot 6 Wire wrapped 9 Drilled holes

2 Louvered shutter 4 Key punched 7 Torch cut 10 Other (specify)






What is the nearest source of possible contamination: 10 Livestock pens 14 Abandoned water well

1 Septic tank 4 Lateral lines 7 Pit privy 11 Fuel storage 15 Oil well/Gas well

2 Sewer lines 5 Cess pool 8 Sewage lagoon 12 Fertilizer storage 16 Other (specify below)

3 Watertight sewer lines 6 Seepage pit 9 Feedyard 13 Insecticide storage

Direction from well? S-E How many feet? 100+

FROM TO LITHOLOGIC LOG FROM TO PLUGGING INTERVALS

0 4 Clay 0 4

4 70 Shale 4 70

7 CONTRACTOR'S OR LANDOWNER'S CERTIFICATION: This water well was (1) constructed, (2) reconstructed, or (3) plugged under my jurisdiction and was completed on (mo/day/year) 1-29-89 and this record is true to the best of my knowledge and belief. Kansas

Water Well Contractor's License No. 1744 This Water Well Record was completed on (mo/day/yr) 6-24-89

under the business name of Carl Vincent Service by (signature) Carl Vincent