


1 LOCATION OF WATER WELL: County: Hamilton		Fraction SE ¼ SE ¼ NW ¼	Section Number 17	Township Number T 26 S	Range Number R 40 E/W
---	--	----------------------------	----------------------	---------------------------	--------------------------

Distance and direction from nearest town or city street address of well if located within city?
14½ miles north and 2 east of Johnson, Kansas

2	WATER WELL OWNER:	Ronald E. Finlay	
	RR#, St. Address, Box # :	Box 60A	Board of Agriculture, Division of Water Resources
	City, State, ZIP Code :	Kendall, Kansas 67857	Application Number:

LOCATE WELL'S LOCATION WITH AN "X" IN SECTION BOX: 4 DEPTH OF COMPLETED WELL: 205 ft. ELEVATION: slope

Depth(s) Groundwater Encountered 1. 85 ft. 2. ft. 3. ft.

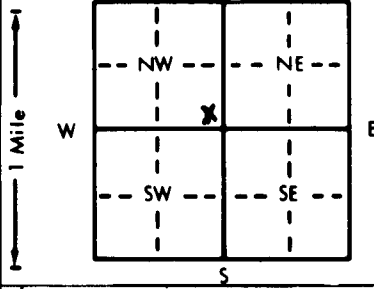

4 DEPTH OF COMPLETED WELL 205 ft. ELEVATION: slope
Depth(s) Groundwater Encountered 1. 85 ft. 2. ft. 3. ft.
WELL'S STATIC WATER LEVEL 85 ft. below land surface measured on mo/day/yr 5/4/94
Pump test data: Well water was WINDMILL ft. after hours pumping gpm
Est. Yield gpm: Well water was WINDMILL ft. after hours pumping gpm
Bore Hole Diameter 9 7/8 in. to 205 ft. and in. to ft.
WELL WATER TO BE USED AS:
1 Domestic 3 Feedlot 6 Oil field water supply 9 Dewatering 11 Injection well
2 Irrigation 4 Industrial 7 Lawn and garden only 10 Monitoring well 12 Other (Specify below)
Was a chemical/bacteriological sample submitted to Department? Yes No X; If yes, mo/day/yr sample was submitted
Water Well Disinfected? Yes X No

5 TYPE OF BLANK CASING USED: 5 Wrought iron 8 Concrete tile CASING JOINTS: Glued ☒ X ☐ Clamped ☐
1 Steel 3 RMP (SR) 6 Asbestos-Cement 9 Other (specify below) Welded ☐
2 PVC 4 ABS 7 Fiberglass Threaded ☐
Blank casing diameter . . . 5 in. to . . 14 5 ft., Dia . . 5 in. to . . 18 5 ft., Dia in. to ft.
Casing height above land surface 24 in., weight schedule 200 lbs./ft. Wall thickness or gauge No. SDR-21

TYPE OF SCREEN OR PERFORATION MATERIAL:				
1 Steel	3 Stainless steel	5 Fiberglass	7 PVC	10 Asbestos-cement
2 Brass	4 Galvanized steel	6 Concrete tile	8 RMP (SR)	11 Other (specify)
			9 ABS	12 None used (open hole)

SCREEN OR PERFORATION OPENINGS ARE:

1 Continuous slot	3 Mill slot	5 Gauzed wrapped	8 Saw cut	11 None (open hole)
2 Louvered shutter	4 Key punched	6 Wire wrapped	9 Drilled holes	
		7 Torch cut	10 Other (specify)	

SCREEN-PERFORATED INTERVALS:	From . . . 1.45	ft. to . . . 1.65	ft., From	ft. to	ft.
	From . . . 1.85	ft. to . . . 2.05	ft., From	ft. to	ft.
GRAVEL PACK INTERVALS:	From . . . 2.0	ft. to . . . 2.05	ft., From	ft. to	ft.
	From	ft. to	ft., From	ft. to	ft.

6 GROUT MATERIAL: 1 Neat cement 2 Cement grout 3 Bentonite 4 Other

Grout Intervals: From 0 ft. to 20 ft. From ft. to ft. From ft. to ft.

What is the nearest source of possible contamination:

1 Septic tank	4 Lateral lines	7 Pit privy	10 Livestock pens	14 Abandoned water well
2 Sewer lines	5 Cess pool	8 Sewage lagoon	11 Fuel storage	15 Oil well/Gas well
3 Watertight sewer lines	6 Seepage pit	9 Feedyard	12 Fertilizer storage	16 Other (specify below)
			13 Insecticide storage	

Direction from well?		south		How many feet?		80	
FROM	TO	LITHOLOGIC LOG		FROM	TO	PLUGGING INTERVALS	

[illegible]

7 CONTRACTOR'S OR LANDOWNER'S CERTIFICATION: This water well was (1) constructed, (2) reconstructed, or (3) plugged under my jurisdiction and was completed on (mo/day/year) 5/5/94 and this record is true to the best of my knowledge and belief. Kansas Water Well Contractor's License No. 164. This Water Well Record was completed on (mo/day/yr) 5-6-94 under the business name of Houck Bros. Drilling CO. by (signature) M. Beard.