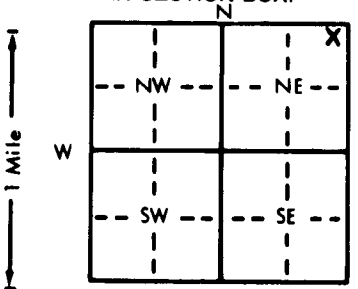


1 LOCATION OF WATER WELL: County: <u>Hamilton</u>		Fraction <u>NE 1/4</u> <u>NE 1/4</u> <u>NE 1/4</u>		Section Number <u>19</u>	Township Number <u>T 26 S</u>	Range Number <u>R 41</u>	
Distance and direction from nearest town or city street address of well if located within city? <u>From Syracuse, Kansas 13 miles South & 4 miles West on Hiway 27</u>	
2 WATER WELL OWNER: <u>Steve McCormick</u> RR#, St. Address, Box # : _____ City, State, ZIP Code : <u>Lakin, Kansas 67860</u> Board of Agriculture, Division of Water Resources Application Number: _____	
3 LOCATE WELL'S LOCATION WITH AN "X" IN SECTION BOX: 		4 DEPTH OF COMPLETED WELL <u>318</u> ft. ELEVATION: _____ ft. Depth(s) Groundwater Encountered 1. _____ ft. 2. _____ ft. 3. _____ ft. WELL'S STATIC WATER LEVEL <u>80</u> ft. below land surface measured on mo/day/yr <u>April 8, 1985</u> Pump test data: Well water was _____ ft. after _____ hours pumping _____ gpm Est. Yield <u>50</u> gpm: Well water was _____ ft. after _____ hours pumping _____ gpm Bore Hole Diameter <u>8</u> in. to <u>318</u> ft., and _____ in. to _____ ft. WELL WATER TO BE USED AS: <table style="width:100%;"><tr><td>5 Public water supply</td><td>8 Air conditioning</td><td>11 Injection well</td></tr><tr><td>1 Domestic</td><td>3 Feedlot</td><td>6 Oil field water supply</td></tr><tr><td>2 Irrigation</td><td>4 Industrial</td><td>7 Lawn and garden only</td></tr><tr><td>9 Dewatering</td><td>12 Other (Specify below)</td><td></td></tr></table> Was a chemical/bacteriological sample submitted to Department? Yes _____ No <u>XX</u> ; If yes, mo/day/yr sample was submitted _____ Water Well Disinfected? Yes <u>XX</u> No _____					5 Public water supply	8 Air conditioning	11 Injection well	1 Domestic	3 Feedlot	6 Oil field water supply	2 Irrigation	4 Industrial	7 Lawn and garden only	9 Dewatering	12 Other (Specify below)	
5 TYPE OF BLANK CASING USED: <table style="width:100%;"><tr><td>1 Steel</td><td>3 RMP (SR)</td><td>5 Wrought iron</td><td>8 Concrete tile</td><td colspan="2">CASING JOINTS: Glued <u>XX</u> Clamped _____</td></tr><tr><td>2 PVC</td><td>4 ABS</td><td>6 Asbestos-Cement</td><td>9 Other (specify below)</td><td colspan="2">Welded _____</td></tr><tr><td colspan="3">Blank casing diameter <u>5</u> in. to <u>318</u> ft., Dia _____ in. to _____ ft.</td><td colspan="3">Threaded _____</td></tr><tr><td colspan="3">Casing height above land surface <u>12</u> in., weight <u>SDR 21</u> lbs./ft.</td><td colspan="3">Wall thickness or gauge No. <u>200</u> psi</td></tr></table> TYPE OF SCREEN OR PERFORATION MATERIAL: <table style="width:100%;"><tr><td>1 Steel</td><td>3 Stainless steel</td><td>5 Fiberglass</td><td>7 PVC</td><td>10 Asbestos-cement</td></tr><tr><td>2 Brass</td><td>4 Galvanized steel</td><td>6 Concrete tile</td><td>8 RMP (SR)</td><td>11 Other (specify) _____</td></tr><tr><td colspan="3">SCREEN OR PERFORATION OPENINGS ARE:</td><td>9 ABS</td><td>12 None used (open hole)</td></tr><tr><td colspan="3">1 Continuous slot</td><td>5 Gauzed wrapped</td><td>8 Saw cut</td></tr><tr><td colspan="3">2 Louvered shutter</td><td>6 Wire wrapped</td><td>11 None (open hole)</td></tr><tr><td colspan="3">4 Key punched</td><td>7 Torch cut</td><td>9 Drilled holes</td></tr><tr><td colspan="3">SCREEN-PERFORATED INTERVALS: From <u>273</u> ft. to <u>315</u> ft.</td><td colspan="2">10 Other (specify) _____</td></tr><tr><td colspan="3">GRAVEL PACK INTERVALS: From <u>20</u> ft. to <u>315</u> ft.</td><td colspan="2"></td></tr>
6 GROUT MATERIAL: 1 Neat cement 2 Cement grout 3 Bentonite 4 Other _____ Grout Intervals: From <u>6</u> ft. to <u>20</u> ft., From _____ ft. to _____ ft., From _____ ft. to _____ ft. What is the nearest source of possible contamination: <u>None</u> <table style="width:100%;"><tr><td>1 Septic tank</td><td>4 Lateral lines</td><td>7 Pit privy</td><td>10 Livestock pens</td><td>14 Abandoned water well</td></tr><tr><td>2 Sewer lines</td><td>5 Cess pool</td><td>8 Sewage lagoon</td><td>11 Fuel storage</td><td>15 Oil well/Gas well</td></tr><tr><td>3 Watertight sewer lines</td><td>6 Seepage pit</td><td>9 Feedyard</td><td>12 Fertilizer storage</td><td>16 Other (specify below)</td></tr><tr><td colspan="3"></td><td>13 Insecticide storage</td><td></td></tr></table> Direction from well? _____ How many feet? _____							1 Septic tank	4 Lateral lines	7 Pit privy	10 Livestock pens	14 Abandoned water well	2 Sewer lines	5 Cess pool	8 Sewage lagoon	11 Fuel storage	15 Oil well/Gas well	3 Watertight sewer lines	6 Seepage pit	9 Feedyard	12 Fertilizer storage	16 Other (specify below)				13 Insecticide storage	
<table border="1" style="width:100%; border-collapse: collapse;"><thead><tr><th>FROM</th><th>TO</th><th>LITHOLOGIC LOG</th><th>FROM</th><th>TO</th><th>LITHOLOGIC LOG</th></tr></thead><tbody><tr><td>0</td><td>15</td><td>Top soil & clay</td><td></td><td></td><td></td></tr><tr><td>15</td><td>90</td><td>Clay</td><td></td><td></td><td></td></tr><tr><td>90</td><td>135</td><td>Clay & Fine sand in layers</td><td></td><td></td><td></td></tr><tr><td>135</td><td>150</td><td>Fine to medium sand & clay (3 ft.)</td><td></td><td></td><td></td></tr><tr><td>150</td><td>165</td><td>Fine to medium sand & clay</td><td></td><td></td><td></td></tr><tr><td>165</td><td>180</td><td>Medium to coarse sand & blue clay</td><td></td><td></td><td></td></tr><tr><td>180</td><td>195</td><td>Medium sand & brown rusty clay</td><td></td><td></td><td></td></tr><tr><td>195</td><td>240</td><td>Clay</td><td></td><td></td><td></td></tr><tr><td>240</td><td>255</td><td>Clay & sand stone (10 ft.)</td><td></td><td></td><td></td></tr><tr><td>255</td><td>285</td><td>Sand stone</td><td></td><td></td><td></td></tr><tr><td>285</td><td>300</td><td>Sand stone</td><td></td><td></td><td></td></tr><tr><td>300</td><td>315</td><td>Sand stone</td><td></td><td></td><td></td></tr><tr><td>315</td><td>320</td><td>Blue shale</td><td></td><td></td><td></td></tr><tr><td></td><td></td><td></td><td></td><td></td><td></td></tr><tr><td></td><td></td><td></td><td></td><td></td><td></td></tr><tr><td></td><td></td><td></td><td></td><td></td><td></td></tr>
7 CONTRACTOR'S OR LANDOWNER'S CERTIFICATION: This water well was (1) constructed, (2) reconstructed, or (3) plugged under my jurisdiction and was completed on (mo/day/year) <u>April 9, 1985</u> and this record is true to the best of my knowledge and belief. Kansas Water Well Contractor's License No. <u>179</u> This Water Well Record was completed on (mo/day/yr) <u>May 8, 1985</u> under the business name of <u>Joe's Well Service, Inc. Cimarron, Ks.</u> by (signature) <u>Indith Cusk</u> INSTRUCTIONS: Use typewriter or ball point pen, <u>PLEASE PRESS FIRMLY</u> and <u>PRINT</u> clearly. Please fill in blanks, underline or circle the correct answers, Send top three copies to Kansas Department of Health and Environment, Division of Environment, Environmental Geology Section, Topeka, KS 66620. Send one to WATER WELL OWNER and retain one for your records.	