


Hamilton

WATER WELL RECORD Form WWC-5 KSA 82a-1212

1 LOCATION OF WATER WELL: Fraction SW 1/4 NW 1/4 NW 1/4 Section Number 26 Township Number T 26 S Range Number R 42 EW
 County: HAMILTON
 Distance and direction from nearest town or city street address of well if located within city?
MIINTER KANSAS - 16 3/4 mi North & East -

2 WATER WELL OWNER: ELDON HAMILIN Ph# 316-372-2386
 RR#, St. Address, Box #: HC 01 BOX 47
 City, State, ZIP Code: SYRACUSE, KS.
 Board of Agriculture, Division of Water Resources
 Application Number:

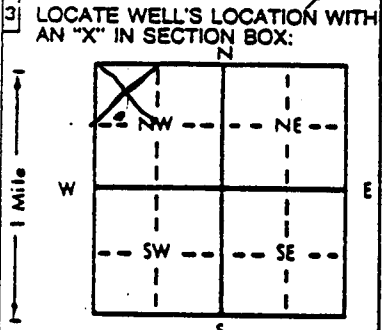

4 DEPTH OF COMPLETED WELL: 300 ft. ELEVATION: ft.
 Depth(s) Groundwater Encountered 1. ft. 2. ft. 3. ft.
 WELL'S STATIC WATER LEVEL 215 ft. below land surface measured on mo/day/yr 7-21-96
 Pump test data: Well water was ft. after hours pumping gpm
 Est. Yield gpm; Well water was ft. after hours pumping gpm
 Bore Hole Diameter 12 1/4 in. to 18 in. and 9 in. to 300 in.
 WELL WATER TO BE USED AS:
 1 Domestic 3 Feedlot 6 Oil field water supply 9 Dewatering 11 Injection well
 2 Irrigation 4 Industrial 7 Lawn and garden only 10 Observation well 12 Other (Specify below)
 Was a chemical/bacteriological sample submitted to Department? Yes.....No If yes, mo/day/yr sample was submitted
 Water Well Disinfected? Yes No

5 TYPE OF BLANK CASING USED:
 1 Steel 3 RMP (SR) 5 Wrought iron 8 Concrete tile CASING JOINTS: Glued Clamped
 2 PVC 4 ABS 6 Asbestos-Cement 9 Other (specify below) Welded
 7 Fiberglass Threaded
 Blank casing diameter 5 5/8 in. to 260 ft. Dia. in. to ft. Dia. in. to ft.
 Casing height above land surface 30 in., weight 200 lbs./ft. Wall thickness or gauge No. 5DR-21
 TYPE OF SCREEN OR PERFORATION MATERIAL:
 1 Steel 3 Stainless steel 5 Fiberglass 7 PVC 10 Asbestos-cement
 2 Brass 4 Galvanized steel 6 Concrete tile 8 RMP (SR) 11 Other (specify)
 12 None used (open hole)
 SCREEN OR PERFORATION OPENINGS ARE:
 1 Continuous slot 3 Mill slot 5 Gauzed wrapped 8 Saw cut 11 None (open hole)
 2 Louvered shutter 4 Key punched 6 Wire wrapped 9 Drilled holes
 7 Torch cut 10 Other (specify)
 SCREEN-PERFORATED INTERVALS: From 260 ft. to 300 ft., From ft. to ft.
 GRAVEL PACK INTERVALS: From 200 ft. to 300 ft., From ft. to ft.

6 GROUT MATERIAL: 1 Neat cement 2 Cement grout 3 Bentonite 4 Other
 Grout Intervals: From 5 ft. to 16 ft., From 16 ft. to 18 ft., From ft. to ft.
 What is the nearest source of possible contamination:
 1 Septic tank 4 Lateral lines 7 Pit privy 10 Livestock pens 14 Abandoned water well
 2 Sewer lines 5 Cess pool 8 Sewage lagoon 11 Fuel storage 15 Oil well/Gas well
 3 Watertight sewer lines 6 Seepage pit 9 Feedyard 12 Fertilizer storage 16 Other (specify below)
 13 Insecticide storage
 Direction from well? West How many feet? 75

FROM	TO	LITHOLOGIC LOG	FROM	TO	LITHOLOGIC LOG
0	4	Top Soil	262	277	SAND
4	11	TAN SANDY CLAY	277	282	WHITE CLAY
11	17	TAN CLAY	282	300	SAND & SANDSTONE
17	87	TAN SANDY CLAY w/ SANDY STREAKS			
87	93	SMALL GRAVEL			
93	110	TAN SANDY CLAY			
110	124	TAN & YELLOW CLAY			
124	130	TAN SANDY CLAY			
130	157	FINE-MED. SAND w/ SANDY CLAY STREAKS			
157	171	TAN SANDY CLAY w/ CLAY STREAKS			
171	186	TAN CLAY			
186	203	SAND - TAN SANDY CLAY STREAKS			
203	234	TAN, Red, & Yellow SANDY CLAY			
234	257	Red SAND & SANDSTONE			
257	262	SANDSTONE			

RECEIVED

AUG 23 1996

DEPT. OF WATER

7 CONTRACTOR'S OR LANDOWNER'S CERTIFICATION: This water well was (1) constructed (2) reconstructed, or (3) plugged under my jurisdiction and completed on (mo/day/year) 8-2-96 and this record is true to the best of my knowledge and belief. -Kansas Water Well Contractor's License No. 600-A This Water Well Record was completed on (mo/day/yr) 8-12-96 under the business name of CRAMER DRILLING CO. by (signature) Ray Cramer
 INSTRUCTIONS: Use typewriter or ball point pen, PLEASE PRESS FIRMLY and PRINT clearly. Please fill in blanks, underline or circle the correct answers. Send top three copies to Kansas Department of Health and Environment, Division of Environment, Environmental Geology Section, Topeka, KS 66620. Send one to WATER WELL OWNER and retain one for your records.