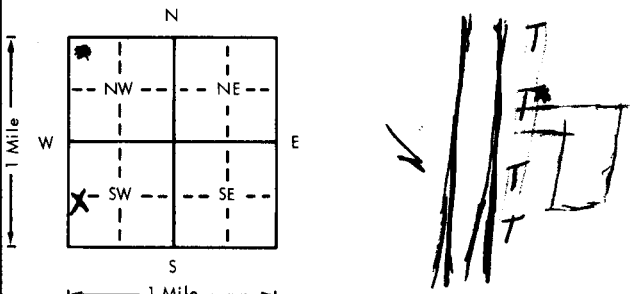


USE TYPEWRITER OR BALL POINT PEN—PRESS FIRMLY, PRINT CLEARLY.

WATER WELL RECORD
KSA 82a-1201-1215

Kansas Department of Health and Environment—Division of Environment
(Water well Contractors)
Topeka, Kansas 66620

1. Location of well: County Hamilton		Fraction NW 1/4 SW 1/4 SW 1/4		Section number 18		Township number T 26 S R 42 E/W		Range number	
2. Distance and direction from nearest town or city: Syracuse, KS 105 - 11 W - 234 S Street address of well location if in city:				3. Owner of well: GEORGE FOX R.R. or street: South Route B#16 City, state, zip code: SYRACUSE, KANSAS 67878					
4. Locate with "X" in section below: 				Sketch map:		6. Bore hole dia. 4" in. Completion date 6-4-79 Well depth 390' ft.			
						7. <input type="checkbox"/> Cable tool <input checked="" type="checkbox"/> Rotary <input type="checkbox"/> Driven <input type="checkbox"/> Dug <input type="checkbox"/> Hollow rod <input type="checkbox"/> Jetted <input type="checkbox"/> Bored <input type="checkbox"/> Reverse rotary			
						8. Use: <input checked="" type="checkbox"/> Domestic <input type="checkbox"/> Public supply <input type="checkbox"/> Industry <input type="checkbox"/> Irrigation <input type="checkbox"/> Air conditioning <input type="checkbox"/> Stock <input type="checkbox"/> Lawn <input type="checkbox"/> Oil field water <input type="checkbox"/> Other			
						<input checked="" type="checkbox"/> Casing: Material _____ Height: Above or below Threaded _____ Welded _____ Surface 12 in. RMP _____ PVC <input checked="" type="checkbox"/> Weight _____ lbs./ft. Dia. 5" in. to 390' ft. depth Wall Thickness: inches or Dia. _____ in. to _____ ft. depth gage No. 262			
5. Type and color of material				From		To		<input checked="" type="checkbox"/> Screen: Manufacturer's name Jetstream Type A Dia. 5 Slot/gauze 2HT Length 40 Set between 390 ft. and 350 ft. _____ ft. and _____ ft. Gravel pack? _____ Size range of material _____	
0-20' fine SAND				0		20'		11. Static water level: _____ mo./day/yr. 165' ft. below land surface Date 6-4-79	
CLAY				20'		65'		12. Pumping level below land surfaces: NA _____ ft. after _____ hrs. pumping _____ g.p.m. _____ ft. after _____ hrs. pumping _____ g.p.m. Estimated maximum yield _____ g.p.m.	
CLAY - fine SAND				65'		100'		13. Water sample submitted: _____ mo./day/yr. Yes <input checked="" type="checkbox"/> No <input type="checkbox"/> Date _____	
CLAY				100'		175'		14. Well head completion: _____ Pitless adapter _____ Inches above grade	
COURSE SAND				175'		215'		15. Well grouted? _____ With: _____ Neat cement <input checked="" type="checkbox"/> Bentonite _____ Concrete _____ Depth: From 20 ft. to 5' ft.	
ROCK + SANDSTONE				215'		260'		16. Nearest source of possible contamination: ft. 200 Direction East Type Sewer Well disinfected upon completion? <input checked="" type="checkbox"/> Yes _____ No _____	
Blue shell				260'		270'		17. Pump: NA _____ Not installed Manufacturer's name _____ Model number _____ HP _____ Volts _____ Length of drop pipe _____ ft. capacity _____ g.p.m. Type: <input type="checkbox"/> Submersible <input type="checkbox"/> Turbine <input type="checkbox"/> Jet <input type="checkbox"/> Reciprocating <input type="checkbox"/> Centrifugal <input type="checkbox"/> Other	
400 psi (80%) Sandstone in Blue shell				270'		305'			
100 psi (20%) Blue shell + sandstone				305'		345'			
(100%) Sandstone core, loose				345'		390'			
(Use a second sheet if needed)									
18. Elevation:		19. Remarks:							
Topography: <input type="checkbox"/> Hill <input checked="" type="checkbox"/> Slope <input type="checkbox"/> Upland <input type="checkbox"/> Valley		20. Water well contractor's certification: This well was drilled under my jurisdiction and this report is true to the best of my knowledge and belief. James Smith Pump Ser. 160 Business name _____ License No. _____ Address Johnson, Kans. 67852 Signed James Ray Smith Date 12/79 Authorized representative							

T 26
 R 42
 E/W
 18
 Sec
 1/4 1/4 1/4
 NWSUBSU