

CORRECTION(S) TO WATER WELL RECORD (WWC-5)

(to rectify lacking or incorrect information)

County: Hamilton

Location listed as:

Location ~~changed to~~

Section-Township-Range: \_\_\_\_\_

22 - 26 S - 42 W

Fraction (  $\frac{1}{4}$   $\frac{1}{4}$   $\frac{1}{4}$ ): \_\_\_\_\_

SE NE NE

Other changes: Initial statements: Stanton County

Changed to: Hamilton County

Comments: \_\_\_\_\_

verification method: Written & legal descriptions, and mapping tool on KGS website.

initials: ARL date: 7/28/2006

submitted by: Kansas Geological Survey, Data Resources Library, 1930 Constant Ave., Lawrence, KS 66047-3726  
to: Kansas Dept of Health & Environment, Bureau of Water, 1000 SW Jackson, Suite 420, Topeka, KS 66612-1367.


WATER WELL RECORD Form WWC-5 KSA 82a-1212

1 LOCATION OF WATER WELL: Fraction Section Number Township Number Range Number  
 COUNTY: STANTION SE 1/4 NE 1/4 NE 1/4 22 T 26 S R 42 W

Distance and direction from nearest town or city street address of well if located within city?  
 FROM MANTER - 20 MILES NORTH ON MANTER GRADE ROAD

2 WATER WELL OWNER: WESTERMAN, MIKE  
 RR#, St. Address, Box #: HC 01 -- BOX 48 Board of Agriculture, Division of Water Resources  
 City, State, ZIP code : SYRACUSE, KS 67878- Application Number:

3 LOCATE WELL'S LOCATION WITH AN "X" IN SECTION BOX: 4 DEPTH OF COMPLETED WELL 520 ELEVATION: 0  
 Depth(s) Groundwater Encountered 1. 0 ft. 2. 0 ft. 3. 0 ft.

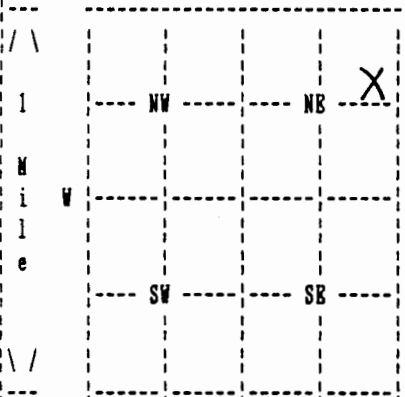

WELL'S STATIC WATER LEVEL 202 ft. below land surface measured on no/day/yr 06/12/06  
 Pump test data: Well water was 0 ft. after 0 hours pumping 0 gpm

Estimated Yield 50 gpm: Well water was 0 ft. after 0 hours pumping 0 gpm

Bore Hole Diameter 9 in. to 520 ft., and in. to 0 ft.

WELL WATER TO BE USED AS: DOMESTIC

Was a chemical/bacteriological sample submitted to department? No ;  
 If yes, no/day/yr sample was submitted Water well disinfected? Yes

5 TYPE OF BLANK CASING USED: CERTA LOC CASIN CASING JOINTS: CERTA-LOC  
 Blank casing diameter 5 in. to 520 ft., Dia in. to 0 ft., Dia in. to 0 ft.  
 Casing height above land surface 12 in., weight 200 lbs/ft. Wall thickness or gauge No. 17  
 TYPE OF SCREEN OR PERFORATION MATERIAL: PVC  
 SCREEN OR PERFORATION OPENINGS ARE: SAW CUT

SCREEN PERFORATED INTERVALS: From 340 ft. to 400 ft., From 0 ft. to 0 ft.  
 From 480 ft. to 520 ft., From 0 ft. to 0 ft.  
 GRAVEL PACK INTERVALS: From 25 ft. to 520 ft., From 0 ft. to 0 ft.  
 From 0 ft. to 0 ft., From 0 ft. to 0 ft.

6 GROUT MATERIAL BENTONITE  
 Grout Intervals: From 5 ft. to 25 ft., From 0 ft. to 0 ft., From 0 ft. to 0 ft.  
 What is the nearest source of possible contamination: NONE  
 Direction from well? How many feet? 0

FROM	TO	LITHOLOGIC LOG	FROM	TO	PLUGGING INTERVALS
0	20	01 TOPSOIL 32 TAN CLAY			
20	40	32 TAN CLAY 02 PINE SAND			
40	80	02 PINE SAND			
80	120	02 PINE SAND 32 TAN CLAY 19 LAYERS			
120	220	32 TAN CLAY			
220	240	32 TAN CLAY BROWN 27 ROCK			
240	380	40 TAN SANDSTON			
380	400	40 TAN SANDSTON 29 SANDSTONE (Dray)			
400	480	29 SANDSTONE (Dray)			
480	540	40 TAN SANDSTON			

7 CONTRACTOR'S OR LANDOWNER'S CERTIFICATION: This water well was Constructed under my jurisdiction and was completed on (no/day/year) 06/13/06 and this record is true to the best of my knowledge and belief. Kansas Water Well Contractor's License No. 179 This Water Well Record was completed on (no/day/yr) 06/22/06 under the business name of JOB'S WELL SERVICE, INC. by (signature) Judith Cuck