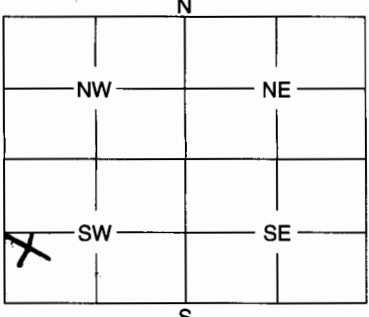


1 LOCATION OF WATER WELL: Fraction Section Number Township Number Range Number  
 County: Hamilton NW 1/4 SW 1/4 SW 1/4 15 26 42 E/W  
 Distance and direction from nearest town or city street address of well if located within city?

2 WATER WELL OWNER: Westman Farms LTD  
HCO1 Box 46  
 RR #, St. Address, Box #: Syracuse, KS 67878 Board of Agriculture, Division of Water Resources  
 City, State, ZIP Code : Syracuse, KS 67878 Application Number:

3 MARK WELL'S LOCATION WITH AN "X" IN SECTION BOX:  
  
 4 DEPTH OF WELL ..... 250 ..... ft.  
 WELL'S STATIC WATER LEVEL ..... 175 ..... ft.  
 WELL WAS USED AS:  
 1 Domestic 5 Public Water Supply 9 Dewatering  
 2 Irrigation 6 Oil Field Water Supply 10 Monitoring Well  
 3 Feedlot 7 Domestic (Lawn & Garden) 11 Injection Well  
 4 Industrial 8 Air Conditioning 12 Other .....  
 Was a chemical / bacteriological sample submitted to Department? Yes ..... No X.....  
 If yes, mo/day/yr sample was submitted .....  
 Water Well Disinfected: Yes X..... No .....

5 TYPE OF BLANK CASING USED:  
 1 Steel 3 RMP (SR) 5 Wrought 7 Fiberglass 9 Other (Specify below)  
 2 PVC 4 ABS 6 Asbestos-Cement 8 Concrete Tile .....  
 Blank casing diameter ..... 5 ..... in. Was casing pulled? Yes ..... No X..... If yes, how much .....  
 Casing height above or below land surface Below 36 ..... in.

6 GROUT PLUG MATERIAL: 1 Neat cement 2 Cement grout 3 Bentonite 4 Other .....  
 Grout Plug Intervals: From ..... 16 ..... ft. to ..... 170 ..... ft., From ..... ft. to ..... ft., From ..... to ..... ft.  
 What is the nearest source of possible contamination:  
 1 Septic tank 6 Seepage pit 11 Fuel storage 16 Other (specify below) FARIG Water Well  
 2 Sewer lines 7 Pit privy 12 Fertilizer storage  
 3 Watertight sewer lines 8 Sewage lagoon 13 Insecticide storage  
 4 Lateral lines 9 Feedyard 14 Abandoned water well  
 5 Cess pool 10 Livestock pens 15 Oil well/Gas well  
 Direction from well? ..... SE ..... How many feet? ..... 1320 .....

FROM	TO	PLUGGING MATERIALS
0	16ft	sub soil
16ft	170ft	Cement
170ft	250ft	Disinfected sand

7 CONTRACTOR'S OF LANDOWNER'S CERTIFICATION: This water well was plugged under my jurisdiction and was completed on (mo/day/year) ..... 8-10-06 ..... and this record is true to the best of my knowledge and belief. Kansas Water Well Contractor's License No. .... This Water Well Record was completed on (mo/day/year) ..... under the business name of ..... by (signature) Rodger Westman .....

INSTRUCTIONS: Use typewriter or ball point pen. Please press firmly and print clearly. Please fill in blanks, underline or circle the correct answers. Send top three copies to Kansas Department of Health and Environment, Bureau of Water, Geology Section, 1000 SW Jackson St., Ste. 420, Topeka, Kansas 66612-1367. Telephone: 785/296-5522. Send one to Water Well Owner and retain one for your records.