


1 LOCATION OF WATER WELL: Fraction Section Number Township Number Range Number
 County: Hamilton SW 1/4 SW 1/4 SW 1/4 15 26 42 E/W
 Distance and direction from nearest town or city street address of well if located within city?

2 WATER WELL OWNER: Westeman Farms LTD
Hc01 Box 46
 RR #, St. Address, Box #: Syracuse, KS 67878 Board of Agriculture, Division of Water Resources
 City, State, ZIP Code: Syracuse, KS 67878 Application Number: 6309

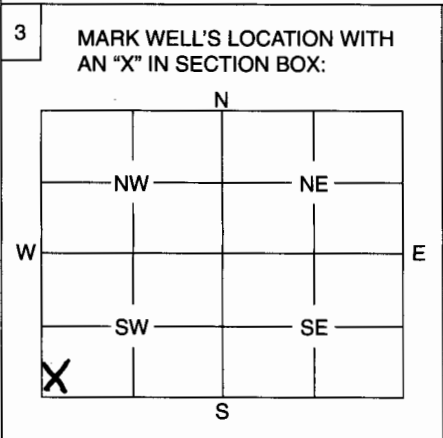

4 DEPTH OF WELL 350 ft.
 WELL'S STATIC WATER LEVEL 173 ft.
 WELL WAS USED AS:
 1 Domestic 2 Irrigation 5 Public Water Supply 9 Dewatering
 3 Feedlot 7 Domestic (Lawn & Garden) 10 Monitoring Well
 4 Industrial 8 Air Conditioning 11 Injection Well
 12 Other
 Was a chemical / bacteriological sample submitted to Department? Yes No X.....
 If yes, mo/day/yr sample was submitted
 Water Well Disinfected: Yes X No

5 TYPE OF BLANK CASING USED:
 1 Steel 3 RMP (SR) 5 Wrought 7 Fiberglass 9 Other (Specify below)
 2 PVC 4 ABS 6 Asbestos-Cement 8 Concrete Tile
 Blank casing diameter 12 in. Was casing pulled? Yes No X..... If yes, how much
 Casing height above or below land surface above 12 in.

6 GROUT PLUG MATERIAL: 1 Neat cement 2 Cement grout 3 Bentonite 4 Other
 Grout Plug Intervals: From 15 ft. to 20 ft., From ft. to ft., From to ft.
 What is the nearest source of possible contamination:
 1 Septic tank 6 Seepage pit 11 Fuel storage 16 Other (specify below) IRRIG. Water Well
 2 Sewer lines 7 Pit privy 12 Fertilizer storage
 3 Watertight sewer lines 8 Sewage lagoon 13 Insecticide storage
 4 Lateral lines 9 Feedyard 14 Abandoned water well
 5 Cess pool 10 Livestock pens 15 Oil well/Gas well
 Direction from well? NE How many feet? 1220

FROM	TO	PLUGGING MATERIALS
<u>0</u>	<u>15ft</u>	<u>sub soil</u>
<u>15ft</u>	<u>20ft</u>	<u>Cement</u>
<u>20ft</u>	<u>170ft.</u>	<u>sub soil</u>
<u>170ft</u>	<u>350ft.</u>	<u>Disinfected sand</u>

7 CONTRACTOR'S OF LANDOWNER'S CERTIFICATION: This water well was plugged under my jurisdiction and was completed on (mo/day/year) 8-12-06 and this record is true to the best of my knowledge and belief. Kansas Water Well Contractor's License No. This Water Well Record was completed on (mo/day/year) under the business name of
 by (signature) Rodger Westeman

INSTRUCTIONS: Use typewriter or ball point pen. Please press firmly and print clearly. Please fill in blanks, underline or circle the correct answers. Send top three copies to Kansas Department of Health and Environment, Bureau of Water, Geology Section, 1000 SW Jackson St., Ste. 420, Topeka, Kansas 66612-1367. Telephone: 785/296-5522. Send one to Water Well Owner and retain one for your records.