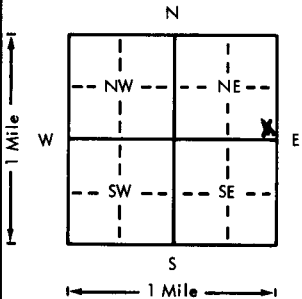


USE TYPEWRITER OR BALL
POINT PEN-PRESS FIRMLY,
PRINT CLEARLY.

WATER WELL RECORD
KSA 82a-1201-1215

Kansas Department of Health and
Environment-Division of Environment
(Water well Contractors)
Topeka, Kansas 66620

1. Location of well:		County Hamilton	Fraction SE 1/4 SE 1/4 NE 1/4	Section number 2	Township number T 26 S R 43	Range number E 12
2. Distance and direction from nearest town or city: Johnson, Ks. 17 miles north, 12 west, 1/2 south			3. Owner of well: W. T. Hughes R.R. or street: South Route City, state, zip code: Syracuse, Ks. 67878			
4. Locate with "X" in section below:		Sketch map:		6. Bore hole dia. <u>27</u> in. Completion date <u>6/20/77</u> Well depth <u>414</u> ft.		
				7. <input checked="" type="checkbox"/> Cable tool <input checked="" type="checkbox"/> Rotary <input type="checkbox"/> Driven <input type="checkbox"/> Dug <input type="checkbox"/> Hollow rod <input type="checkbox"/> Jetted <input type="checkbox"/> Bored <input type="checkbox"/> Reverse rotary		
5. Type and color of material		From	To	8. Use: <input type="checkbox"/> Domestic <input type="checkbox"/> Public supply <input type="checkbox"/> Industry <input checked="" type="checkbox"/> Irrigation <input type="checkbox"/> Air conditioning <input type="checkbox"/> Stock <input type="checkbox"/> Lawn <input type="checkbox"/> Oil field water <input type="checkbox"/> Other		
Surface		0	2	9. Casing: Material <u>steel</u> Height: <u>Above</u> or below Threaded <input type="checkbox"/> Welded <input checked="" type="checkbox"/> Surface <u>14</u> in. RMP <input type="checkbox"/> PVC <input type="checkbox"/> Weight <u>36.8</u> lbs./ft. Dia. <u>16</u> in. to <u>226</u> ft. depth Wall Thickness: inches or Dia. <u>16</u> in. to <u>226</u> ft. depth Gauge No. <u>219</u>		
Sandy clay		2	30	10. Screen: Manufacturer's name <u>Lakeood</u> <u>Pipe of Texas</u> Type <u>steel</u> Dia. <u>16"</u> Slot/gauze <u>3/16"</u> Length <u>187.2'</u> Set between <u>226.10</u> ft. and <u>414</u> ft. Gravel pack? <input checked="" type="checkbox"/> Size range of material <u>1/4 x 5/8"</u>		
Brown clay		30	40	11. Static water level: <u>205</u> ft. below land surface Date <u>4/19/77</u>		
Fine sand		40	100	12. Pumping level below land surfaces: <u>330</u> ft. after <u>12</u> hrs. pumping <u>1400</u> g.p.m. ft. after <u> </u> hrs. pumping <u> </u> g.p.m. Estimated maximum yield <u>1500</u> g.p.m.		
Fine to medium sand		100	160	13. Water sample submitted: <u> </u> mo./day/yr. Yes <input checked="" type="checkbox"/> No <input type="checkbox"/> Date <u> </u>		
Gray clay		160	210	14. Well head completion: <u> </u> Pitless adapter <u>14</u> inches above grade		
Clay w/sandstone strips		210	232	15. Well grouted? <input checked="" type="checkbox"/> With: <input checked="" type="checkbox"/> Neat cement <input type="checkbox"/> Bentonite <input type="checkbox"/> Concrete Depth: From <u>0</u> to <u>10</u> ft.		
Sandstone tight		232	260	16. Nearest source of possible contamination: ft. <u> </u> Direction <u> </u> Type <u>field</u> Well disinfected upon completion? <u> </u> Yes <input checked="" type="checkbox"/> No <input type="checkbox"/>		
Shale and sandstone		260	360	17. Pump: <input checked="" type="checkbox"/> Not installed Manufacturer's name <u> </u> Model number <u> </u> HP <u> </u> Volts <u> </u> Length of drop pipe <u> </u> ft. capacity <u> </u> g.p.m. Type: <input type="checkbox"/> Submersible <input type="checkbox"/> Turbine <input type="checkbox"/> Jet <input type="checkbox"/> Reciprocating <input type="checkbox"/> Centrifugal <input type="checkbox"/> Other		
Blue shale and sandstone		360	414	20. Water well contractor's certification: This well was drilled under my jurisdiction and this report is true to the best of my knowledge and belief. <u>Houck Bros. Drlg. Co.</u> <u>164</u> Business name License No. Address <u>Box 487, Ulysses, Ks.</u> Signed <u>M. Beard</u> Date <u>6/22/77</u> Authorized representative		
18. Elevation:		19. Remarks:				
Topography: <input type="checkbox"/> Hill <input checked="" type="checkbox"/> Slope <input type="checkbox"/> Upland <input type="checkbox"/> Valley						