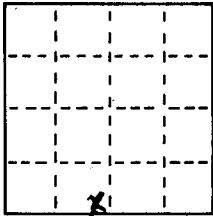
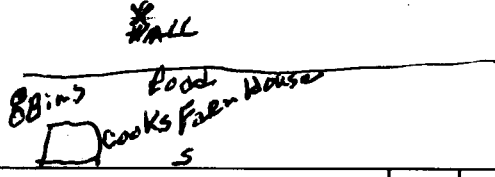


USE TYPEWRITER OR BALL-  
POINT PEN-PRESS FIRMLY,  
PRINT CLEARLY.

WATER WELL RECORD  
KSA 82a-1201-1215

T R EW sec 1/4 1/4 1/4 No.

Kansas State Dept. Of Health  
(Water Well Contractors)  
Forbes-Bldg. 740  
Topeka, Kansas 66620

County <b>HAMILTON</b>		Township name <b>BEAR CREEK</b>		Fraction <b>SW 1/4 SE 1/4 SW 1/4</b>	Section number <b>35</b>	Town number <b>26</b>	Range number <b>43</b>		
Location of well: Distance and direction from nearest town or city: <b>10 S 11 W 55 1 W</b> Street address of well location if in city: <b>IS 1/2 W of SYRACUSE, KANSAS</b>				3 Owner of well: <b>CARL A. MOSER</b> Address: <b>SOUTH RT BOX 29 SYRACUSE, KANSAS 67878</b>					
Locate with "X" in section below: N  W E S 1 Mile		Sketch map: <b>N</b> 		4 Well depth: <b>436</b> ft. Date of completion <b>12-10-75</b> Well diameter <b>28</b> in.					
2		Type and color of material		From		To		5 <input type="checkbox"/> Cable tool <input checked="" type="checkbox"/> Rotary <input type="checkbox"/> Driven <input type="checkbox"/> Dug <input type="checkbox"/> Hollow rod <input type="checkbox"/> Jetted <input type="checkbox"/> Bored <input type="checkbox"/> Reverse rotary	
								6 Use: <input type="checkbox"/> Domestic <input type="checkbox"/> Public supply <input type="checkbox"/> Industry <input checked="" type="checkbox"/> Irrigation <input type="checkbox"/> Air conditioning <input type="checkbox"/> Commercial <input type="checkbox"/> Test well	
								7 Casing: Material <b>STEEL</b> Height: <b>above</b> below Threaded <input type="checkbox"/> Welded <input checked="" type="checkbox"/> Surface <b>18</b> in. Diam. <b>16</b> in. to <b>436</b> ft. depth Drive shoe? <input type="checkbox"/> Yes <input checked="" type="checkbox"/> No	
								8 Screen: Manufacturer <b>JOHNSON</b> Type <b>100 mesh gal</b> Dia. <b>16"</b> Slot gauge <b>1/8 in</b> Length <b>170'</b> Set between <b>266</b> ft. and <b>436</b> ft. Fittings: <b>NONE</b> Gravel pack <input checked="" type="checkbox"/> Yes <input type="checkbox"/> No Size range of material <b>4-8mm</b>	
								9 Static water level: <b>189</b> ft. below land surface Date <b>12-16-75</b>	
								10 Pumping level below land surfaces: <b>240</b> ft. after <b>35</b> hrs. pumping <b>1400</b> g.p.m. <b>263</b> ft. after <b>37</b> hrs. pumping <b>1600</b> g.p.m. Estimated maximum yield <b>1600</b> g.p.m.	
								11 Water sample submitted: <input type="checkbox"/> Yes <input checked="" type="checkbox"/> No Date	
								12 Well head completion: <input type="checkbox"/> Pitless adapter <input checked="" type="checkbox"/> <b>18</b> inches above grade	
								13 Well grouted? <input checked="" type="checkbox"/> Yes <input type="checkbox"/> No <input checked="" type="checkbox"/> Neat cement <input type="checkbox"/> Bentonite <input type="checkbox"/> Depth: From <b>0</b> ft. to <b>12</b> ft.	
								14 Nearest source of possible contamination: <b>NONE</b> ft. Direction Type Well disinfected upon completion? <input type="checkbox"/> Yes <input checked="" type="checkbox"/> No	
								15 Pump: <input type="checkbox"/> Not installed Manufacturer's name <b>LAYNE ROWLER</b> Model number <b>17408</b> HP <b>141</b> Volts <b>NONE</b> Length of drop pipe <b>300</b> ft. capacity <b>1600</b> g.m.p. Type: <input type="checkbox"/> Submersible <input checked="" type="checkbox"/> Turbine <input type="checkbox"/> Jet <input type="checkbox"/> Reciprocating <input type="checkbox"/> Centrifugal <input type="checkbox"/> Other	
								16 Remarks: elevation <b>3230</b> <b>Land slopes to NE</b> Topography: <input type="checkbox"/> Hill <input checked="" type="checkbox"/> Slope <input type="checkbox"/> Upland <input type="checkbox"/> Valley	
								17 Water well contractor's certification: This well was drilled under my jurisdiction and this report is true to the best of my knowledge and belief. <b>Dea Ling, Inc</b> <b>210</b> Business name License No. Address <b>Box 457 Holly, Co 66647</b> Signed <b>J. J. Dineen</b> Date <b>1-12-76</b> Authorized representative	

26 43 W 35 SW SE SW