WATER WELL RECORD Form WWC-5 KSA 82a-

1 LOCATION OF WATER WELL: County: Hamilton | Fraction: NE ¼ NE ¼ NE ¼ | Section Number: 1 | Township Number: T 26 S | Range Number: R ~~36~~ 43 E/W

Distance and direction from nearest town or city street address of well if located within city?
From Johnson Ks. N to Rd. 31, 11W., S into 700 ft

2 WATER WELL OWNER: Hamilton County Dairy
RR#, St. Address, Box # : P.O. Box 1306
City, State, ZIP Code : Syracuse, Ks 67878-1306
Board of Agriculture, Division of Water Resources Application Number:

3 LOCATE WELL'S LOCATION WITH AN "X" IN SECTION BOX:

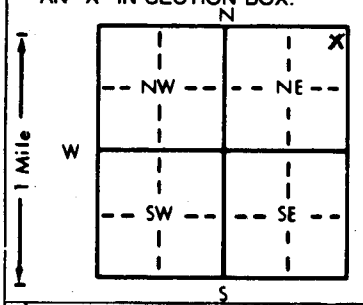

4 DEPTH OF COMPLETED WELL 400 ft. ELEVATION:
Depth(s) Groundwater Encountered 1. 204 ft. 2. ft. 3. ft.
WELL'S STATIC WATER LEVEL 204 ft. below land surface measured on mo/day/yr 2-11-98
Pump test data: Well water was 273 ft. after 1 hours pumping 150 gpm
Est. Yield 150 gpm: Well water was ft. after hours pumping gpm
Bore Hole Diameter 11 in. to 400 ft., and in. to ft.
WELL WATER TO BE USED AS: 1 Domestic 2 Irrigation 3 Feedlot 4 Industrial 5 Public water supply 6 Oil field water supply 7 Lawn and garden only 8 Air conditioning 9 Dewatering 10 Monitoring well 11 Injection well 12 Other (Specify below) Dairy
Was a chemical/bacteriological sample submitted to Department? Yes No X; If yes, mo/day/yr sample was submitted
Water Well Disinfected? Yes X No

5 TYPE OF BLANK CASING USED: 1 Steel 2 PVC 3 RMP (SR) 4 ABS 5 Wrought iron 6 Asbestos-Cement 7 Fiberglass 8 Concrete tile 9 Other (specify below)
CASING JOINTS: Glued X Clamped Welded Threaded
Blank casing diameter 6 in. to 400 ft., Dia in. to ft., Dia in. to ft.
Casing height above land surface 24 in., weight 2.902 lbs./ft. Wall thickness or gauge No. .281 SDR 21

TYPE OF SCREEN OR PERFORATION MATERIAL: 1 Steel 2 Brass 3 Stainless steel 4 Galvanized steel 5 Fiberglass 6 Concrete tile 7 PVC 8 RMP (SR) 9 ABS 10 Asbestos-Cement 11 Other (specify) 12 None used (open hole)

SCREEN OR PERFORATION OPENINGS ARE: 1 Continuous slot 2 Louvered shutter 3 Mill slot 4 Key punched 5 Gauzed wrapped 6 Wire wrapped 7 Torch cut 8 Saw cut 9 Drilled holes 10 Other (specify) 11 None (open hole)

SCREEN-PERFORATED INTERVALS: From 300 ft. to 400 ft., From ft. to ft.
From ft. to ft., From ft. to ft.
GRAVEL PACK INTERVALS: From 80 ft. to 400 ft., From ft. to ft.
From ft. to ft., From ft. to ft.

RECEIVED
APR 20 1998
BUREAU OF WATER

6 GROUT MATERIAL: 1 Neat cement 2 Cement grout 3 Bentonite 4 Other Hole Plug
Grout Intervals: From 0 ft. to 20 ft., From ft. to ft., From ft. to ft.

What is the nearest source of possible contamination:
1 Septic tank 2 Sewer lines 3 Watertight sewer lines 4 Lateral lines 5 Cess pool 6 Seepage pit 7 Pit privy 8 Sewage lagoon 9 Feedyard 10 Livestock pens 11 Fuel storage 12 Fertilizer storage 13 Insecticide storage 14 Abandoned water well 15 Oil well/Gas well 16 Other (specify below)
Direction from well? How many feet?

FROM	TO	LITHOLOGIC LOG
0	25	Clay
25	44	Clay / Sandy Clay
44	50	Clay
50	60	Sand
60	120	Clay
120	160	Clay / Sandy Clay
160	175	Sandy Clay
175	190	Clay / Sandy Clay
190	200	Clay
200	210	Sandstone
210	245	Sandstone / Sand
245	265	Clay
265	280	Sandstone
280	312	Sandstone / Sand
312	320	Clay
320	343	Sand
343	349	Sandstone
349	367	Sand / Sandstone
367	380	Sandstone
380	400	Clay

PLUGGING INTERVALS

Correct Range number

7 CONTRACTOR'S OR LANDOWNER'S CERTIFICATION: This water well was (1) constructed, (2) reconstructed, or (3) plugged under my jurisdiction and was completed on (mo/day/year) 2-11-98 and this record is true to the best of my knowledge and belief. Kansas Water Well Contractor's License No. KWCL - 430 This Water Well Record was completed on (mo/day/yr) 2-11-98 under the business name of HDC AG, L.L.C Box 838 Beaver, Ok 73932 by (signature)

INSTRUCTIONS: Use typewriter or ball point pen. *PLEASE PRESS FIRMLY* and *PRINT* clearly. Please fill in blanks, underline or circle the correct answers. Send top three copies to Kansas Department of Health and Environment, Bureau of Water, Topeka, Kansas 66620-0001. Telephone: 913-296-5545. Send one to WATER WELL OWNER and retain one for your records.

OFFICE USE ONLY T R E/W SEC. ¼ ¼ ¼