


1 LOCATION OF WATER WELL: Fraction Section Number Township Number Range Number  
 COUNTY: 038 HAMILTON Sw 1/4 NW 1/4 SE 1/4 10 T 26 S R 42 W

Distance and direction from nearest town or city street address of well if located within city?  
 FROM SYRACUSE; APPX 12 MILES SOUTH & 7 MILES WEST

2 WATER WELL OWNER: JUSTIN VYN Board of Agriculture, Division of Water Resources  
 RR#, St. Address, Box #: PO BOX 1227 Application Number: 88  
 City, State, ZIP code: SYRACUSE, KS 67878-1227

3 LOCATE WELL'S LOCATION WITH AN "X" IN SECTION BOX:

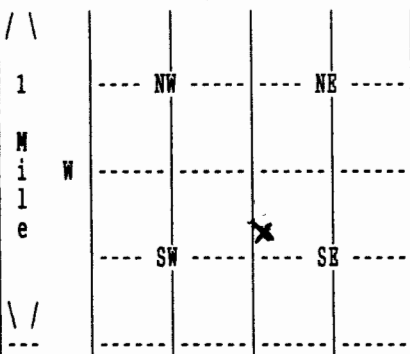

4 DEPTH OF COMPLETED WELL 419 ELEVATION: 0  
 Depth(s) Groundwater Encountered 1. 0 ft. 2. 0 ft. 3. 0 ft.

WELL'S STATIC WATER LEVEL 150 ft. below land surface measured on mo/day/yr 05/10/06  
 Pump test data: Well water was 244 ft. after 4 hours pumping 1000 gpm

Estimated Yield 0 gpm: Well water was 0 ft. after 0 hours pumping 0 gpm

Bore Hole Diameter 24 in. to 419 ft., and in. to 0 ft.

WELL WATER TO BE USED AS: 02 IRRIGATION

Was a chemical/bacteriological sample submitted to department? No;  
 If yes, mo/day/yr sample was submitted Water well disinfected? Yes

5 TYPE OF BLANK CASING USED: 01 STEEL CASING JOINTS: WELDED  
 Blank casing diameter 16 in. to 419 ft., Dia in. to 0 ft., Dia in. to 0 ft.  
 Casing height above land surface 12 in., weight 419 lbs/ft. Wall thickness or gauge No. .250  
 TYPE OF SCREEN OR PERFORATION MATERIAL: 01 STEEL  
 SCREEN OR PERFORATION OPENINGS ARE: 01 CONT. SLOT

SCREEN PERFORATED INTERVALS: From 156 ft. to 216 ft., From 354 ft. to 414 ft.  
 From 237 ft. to 327 ft., From 0 ft. to 0 ft.  
 GRAVEL PACK INTERVALS: From 20 ft. to 419 ft., From 0 ft. to 0 ft.  
 From 0 ft. to 0 ft., From 0 ft. to 0 ft.

6 GROUT MATERIAL 03 BENTONITE  
 Grout Intervals: From 0 ft. to 20 ft., From 0 ft. to 0 ft., From 0 ft. to 0 ft.  
 What is the nearest source of possible contamination: 14 ABAND. WELL  
 Direction from well? NORTH How many feet? 75

FROM	TO	LITHOLOGIC LOG	FROM	TO	PLUGGING INTERVALS
0	2	02 SILT			
2	35	04 SANDY CLAY 20 LIMESTONE 07 FINE SAND			
35	70	05 SAND 11 GRAVEL 01 CLAY			
70	116	04 SANDY CLAY 20 LIMESTONE			
116	137	05 SAND			
137	150	04 SANDY CLAY 05 SAND			
150	177	05 SAND 13 FINE GRAVEL			
177	184	04 SANDY CLAY 05 SAND			
184	187	05 SAND 13 FINE GRAVEL			
187	199	04 SANDY CLAY 05 SAND			

7 CONTRACTOR'S OR LANDOWNER'S CERTIFICATION: This water well was Constructed under my jurisdiction and was completed on (mo/day/year) 05/05/06 and this record is true to the best of my knowledge and belief. Kansas Water Well Contractor's License No. 145 This Water Well Record was completed on (mo/day/yr) 07/03/06 under the business name of HENKLE DRILLING & SUPPLY by (signature)

1 LOCATION OF WATER WELL: COUNTY: 038 HAMILTON	Fraction Sw 1/4 NW 1/4 SE 1/4	Section Number 10	Township Number T 26 S	Range Number R 42 W
---	----------------------------------	----------------------	---------------------------	------------------------

2 WATER WELL OWNER: JUSTIN VYN  
 RR#, St. Address, Box # : PO BOX 1227 Board of Agriculture, Division of Water Resources  
 City, State, ZIP code : SYRACUSE, KS 67878-1227 Application Number: 88

FROM	TO	LITHOLOGIC LOG
199	206	05 SAND 13 FINE GRAVEL
206	210	04 SANDY CLAY
210	216	05 SAND 13 FINE GRAVEL
216	234	19 SHALE
234	247	31 CALICHE 23 SANDSTONE
247	291	23 SANDSTONE 31 CALICHE
291	327	23 SANDSTONE
327	358	31 CALICHE 23 SANDSTONE
358	414	23 SANDSTONE
414	440	19 SHALE

7 CONTRACTOR'S OR LANDOWNER'S CERTIFICATION: This water well was Constructed under my jurisdiction and was completed on (mo/day/year) 05/05/06 and this record is true to the best of my knowledge and belief. Kansas Water Well Contractor's License No. 145 This Water Well Record was completed on (mo/day/yr) 07/03/06 under the business name of HENKLE DRILLING & SUPPLY by (signature) *Brian J. Henkle*