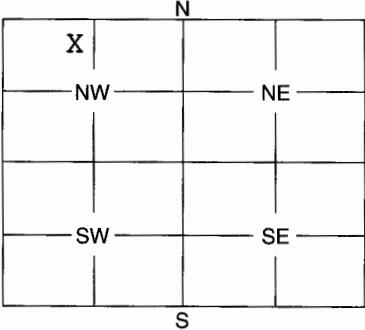


1	LOCATION OF WATER WELL:	Fraction	Section	Number	Township	Number	Range	Number																										
	County: Reno	NE 1/4 NW 1/4 NW 1/4	5		26		5	E W																										
Distance and direction from nearest town or city street address of well if located within city? 2.25 mi E of K-17 on Parallel Rd., Pretty Prairie																																		
2	WATER WELL OWNER: Fred's Bait Shop RR #, St. Address, Box #: 1712 E. Parallel Rd. City, State, ZIP Code : Pretty Prairie, KS 67570 Board of Agriculture, Division of Water Resources Application Number:																																	
3	MARK WELL'S LOCATION WITH AN "X" IN SECTION BOX: 		4	DEPTH OF WELL 11.3 ft. WELL'S STATIC WATER LEVEL n/a ft. WELL WAS USED AS: 1 Domestic 2 Irrigation 3 Feedlot 4 Industrial 5 Public Water Supply 6 Oil Field Water Supply 7 Domestic (Lawn & Garden) 8 Air Conditioning 9 Dewatering 10 Monitoring Well 11 Injection Well 12 Other Was a chemical / bacteriological sample submitted to Department? Yes No X..... If yes, mo/day/yr sample was submitted Water Well Disinfected: Yes No X.....																														
5	TYPE OF BLANK CASING USED: 1 Steel 2 PVC 3 RMP (SR) 4 ABS 5 Wrought 6 Asbestos-Cement 7 Fiberglass 8 Concrete Tile 9 Other (Specify below) Blank casing diameter 2 in. Was casing pulled? Yes X..... No If yes, how much 6'..... Casing height above or below land surface n/a in.																																	
6	GROUT PLUG MATERIAL: 1 Neat cement 2 Cement grout 3 Bentonite 4 Other Native soil Grout Plug Intervals: From 0 ft. to 2 ft., From 2 ft. to 11.3 ft., From to ft. What is the nearest source of possible contamination: 1 Septic tank 2 Sewer lines 3 Watertight sewer lines 4 Lateral lines 5 Cess pool 6 Seepage pit 7 Pit privy 8 Sewage lagoon 9 Feedyard 10 Livestock pens 11 Fuel storage 12 Fertilizer storage 13 Insecticide storage 14 Abandoned water well 15 Oil well/Gas well 16 Other (specify below) Direction from well? NNW How many feet? 150																																	
<table border="1" style="width:100%; border-collapse: collapse;"> <thead> <tr> <th style="width:15%;">FROM</th> <th style="width:15%;">TO</th> <th style="width:70%;">PLUGGING MATERIALS</th> </tr> </thead> <tbody> <tr> <td>0</td> <td>2</td> <td>Native soil</td> </tr> <tr> <td>2</td> <td>11.3</td> <td>Bentonite (8")</td> </tr> <tr><td> </td><td> </td><td> </td></tr> <tr><td> </td><td> </td><td> </td></tr> <tr><td> </td><td> </td><td> </td></tr> <tr><td> </td><td> </td><td> </td></tr> <tr><td> </td><td> </td><td> </td></tr> <tr><td> </td><td> </td><td> </td></tr> </tbody> </table>			FROM	TO	PLUGGING MATERIALS	0	2	Native soil	2	11.3	Bentonite (8")																			MW9 GeoCore #204 KDHE ## U2 078 00857				
FROM	TO	PLUGGING MATERIALS																																
0	2	Native soil																																
2	11.3	Bentonite (8")																																
7	CONTRACTOR'S OF LANDOWNER'S CERTIFICATION: This water well was plugged under my jurisdiction and was completed on (mo/day/year) 4/21/2005 and this record is true to the best of my knowledge and belief. Kansas Water Well Contractor's License No. 527 This Water Well Record was completed on (mo/day/year) 4/22/2005 under the business name of GeoCore Inc. by (signature) <i>Don Kell</i>																																	

INSTRUCTIONS: Use typewriter or ball point pen. Please press firmly and print clearly. Please fill in blanks, underline or circle the correct answers. Send top three copies to Kansas Department of Health and Environment, Bureau of Water, Geology Section, 1000 SW Jackson St., Ste. 420, Topeka, Kansas 66612-1367. Telephone: 785/296-5522. Send one to Water Well Owner and retain one for your records.