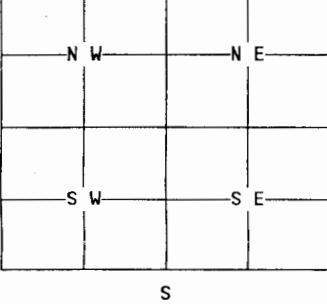


1 LOCATION OF WATER WELL:		Fraction	Section Number	Township Number	Range Number																											
County: Butler		NE 1/4 NE 1/4 NW 1/4	28	26	5 E																											
Distance and direction from nearest town or city street address of well if located within city?																																
2 WATER WELL OWNER: Butler County Landfill																																
RR#, St. Address, Box #: 2963 SW 40th St			Board of Agriculture, Division of Water Resources																													
City, State, ZIP Code : El Dorado KS 67042			Application Number:																													
3 MARK WELL'S LOCATION WITH AN "X" IN SECTION BOX: N  S		4 DEPTH OF WELL.....15.....ft. WELL'S STATIC WATER LEVEL.....3.....ft.  WELL WAS USED AS:  1 Domestic      5 Public Water Supply      9 Dewatering 2 Irrigation      6 Oil Field Water Supply      10 Monitoring Well 3 Feedlot      7 Lawn and Garden Only      11 Injection Well 4 Industrial      8 Air Conditioning      12 Other.....																														
Was a chemical/bacteriological sample submitted to Department? Yes....No.... If yes, mo/day/yr sample was submitted.....																																
Water Well Disinfected: Yes..... No....X....																																
5 TYPE OF BLANK CASING USED:  1 Steel      3 RMP (SR)      5 Wrought      7 Fiberglass      9 Other (specify below) 2 PVC      4 ABS      6 Asbestos-Cement      8 Concrete Tile      ...Corrugated Pipe.....																																
Blank casing diameter.....5.....in.      Was casing pulled? Yes..... No....X.... If yes, how much..... Casing height above or below land surface.....10.....Feet.in.																																
6 GROUT PLUG MATERIAL: 1 Neat cement      2 Cement grout      3 Bentonite      4 Other.....																																
Grout Plug Intervals: From..12..ft. to.10..ft., From.....ft. to .....ft., From..... to.....ft.																																
What is the nearest source of possible contamination:  1 Septic tank      6 Seepage pit      11 Fuel storage      16 Other (specify below) 2 Sewer lines      7 Pit privy      12 Fertilizer storage      ...Landfill..... 3 Watertight sewer lines      8 Sewage lagoon      13 Insecticide storage 4 Lateral lines      9 Feedyard      14 Abandoned water well 5 Cess Pool      10 Livestock pens      15 Oil well/Gas well																																
Direction from well? ...Southwest.....      How many feet? .....100.....feet.....																																
<table border="1"> <thead> <tr> <th>FROM</th> <th>TO</th> <th>PLUGGING MATERIALS</th> </tr> </thead> <tbody> <tr> <td>15'</td> <td>12'</td> <td>Sand</td> </tr> <tr> <td>12'</td> <td>10'</td> <td>Bentonite</td> </tr> <tr> <td>10'</td> <td>3'</td> <td>Subsoil</td> </tr> <tr> <td>3'</td> <td>0</td> <td>Topsoil</td> </tr> <tr> <td></td> <td></td> <td></td> </tr> </tbody> </table>						FROM	TO	PLUGGING MATERIALS	15'	12'	Sand	12'	10'	Bentonite	10'	3'	Subsoil	3'	0	Topsoil												
FROM	TO	PLUGGING MATERIALS																														
15'	12'	Sand																														
12'	10'	Bentonite																														
10'	3'	Subsoil																														
3'	0	Topsoil																														
7 CONTRACTOR'S OR LANDOWNER'S CERTIFICATION: This water well was plugged under my jurisdiction and was complete on (mo/day/year).... and this record is true to the best of my knowledge and belief. Kansas Water Well Contractor's License No. .... This Water Well Record was completed on (mo/day/year) ..27.November.2006.... under the business name of ..Butler.County.Landfill.... by (signature) .. <i>Butler County Landfill</i> .....																																

Kansas Dept. of Health & Environment  
Bureau of Water - Geology Section  
1000 SW Jackson Street, Suite 420  
Topeka KS 66612-1367

3 Copies to KDHE  
1 Copy to Well Owner  
1 Copy to Contractor