


1 LOCATION OF WATER WELL:	Fraction	Section Number	Township Number	Range Number

Distance and direction from nearest town or city street address of well if located within city?

1 mile W. & 1 1/2 miles N. of Mt. Vernon

2 WATER WELL OWNER: Henry Windsor	Board of Agriculture, Division of Water Resources
RR#, St. Address, Box #: P.O. Box 12344	Application Number:
City, State, ZIP Code: Wichita, KS 67227	

3 LOCATE WELL'S LOCATION WITH AN "X" IN SECTION BOX:	4 DEPTH OF COMPLETED WELL: 78 ft. ELEVATION: 4/22/95
--	--

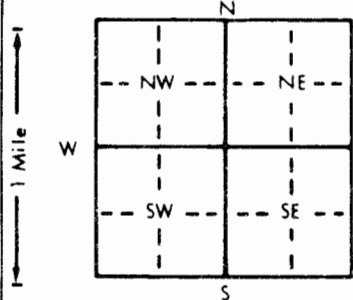

Depth(s) Groundwater Encountered: 30 ft. 2. 30 ft. 3. 4/22/95
WELL'S STATIC WATER LEVEL: 30 ft. below land surface measured on mo/day/yr
WELL WATER TO BE USED AS:
1 Domestic 3 Feedlot 6 Oil field water supply 9 Dewatering 12 Other (Specify below)
2 Irrigation 4 Industrial 7 Lawn and garden only 10 Monitoring well
Was a chemical/bacteriological sample submitted to Department? Yes X No X ; If yes, mo/day/yr sample was submitted
Water Well Disinfected? Yes X No X

5 TYPE OF BLANK CASING USED:	5 Wrought iron	8 Concrete tile	CASING JOINTS: Glued X Clamped
1 Steel 2 PVC	3 RMP (SR)	6 Asbestos-Cement	9 Other (specify below)
4 ABS	7 Fiberglass		Welded
			Threaded

Casing height above land surface: 12 in. weight 2.60 lbs./ft. Wall thickness or gauge No. 160 PSI

TYPE OF SCREEN OR PERFORATION MATERIAL:	7 PVC	10 Asbestos-cement
1 Steel	8 RMP (SR)	11 Other (specify)
2 Brass	9 ABS	12 None used (open hole)
3 Stainless steel		
4 Galvanized steel		
5 Fiberglass		
6 Concrete tile		

SCREEN OR PERFORATION OPENINGS ARE:	5 Gauzed wrapped	8 Saw cut	11 None (open hole)
1 Continuous slot	6 Wire wrapped	9 Drilled holes	
2 Louvered shutter	7 Torch cut	10 Other (specify)	
3 Mill slot			
4 Key punched			



What is the nearest source of possible contamination:	10 Livestock pens	14 Abandoned water well
1 Septic tank	11 Fuel storage	15 Oil well/Gas well
2 Sewer lines	12 Fertilizer storage	16 Other (specify below)
3 Watertight sewer lines	13 Insecticide storage	
4 Lateral lines		
5 Cess pool		
6 Seepage pit		
7 Pit privy		
8 Sewage lagoon		
9 Feedyard		

Direction from well? Southwest	How many feet? 100
---------------------------------------	---------------------------

FROM	TO	LITHOLOGIC LOG	FROM	TO	PLUGGING INTERVALS
0	5	top soil			
5	15	sand			
15	25	clay			
25	78	Shale			

7 CONTRACTOR'S OR LANDOWNER'S CERTIFICATION: This water well was (1) constructed, (2) reconstructed, or (3) plugged under my jurisdiction and was completed on (mo/day/year) 5-1-95 and this record is true to the best of my knowledge and belief. Kansas Water Well Contractor's License No. 318 This Water Well Record was completed on (mo/day/yr) 5-1-95 under the business name of Weninger Drilling by (signature) Karina Morrissey
