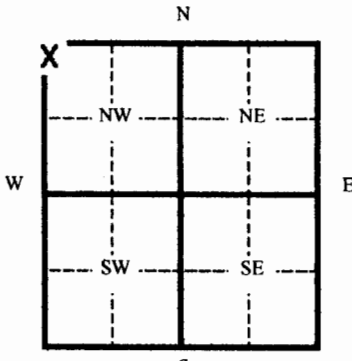


1 LOCATION OF WATER WELL:	Fraction	Section Number	Township Number	Range Number
County: Reno	NW ¼ NW ¼ NW ¼	18	26	6

Distance and direction from nearest town or city street address of well if located within city?

McCubbin Oil - Pretty Prairie, Ks

2 WATER WELL OWNER: Robert Kriesel	Board of Agriculture, Division of Water Resources Application Number: MW-5
RR#, St. Address, Box # 124 E. Main St.	
City, State, ZIP Code : Pretty Prairie Ks	

3 MARK WELL'S LOCATON WITH AN "X" IN SECTION BOX:	4 DEPTH OF WELL 30.4 ft.												
	WELL'S STATIC WATER LEVEL 25 ft.												
	WELL WAS USED AS:												
	<table border="0"><tr><td>1 Domestic</td><td>5 Public Water Supply</td><td>9 Dewatering</td></tr><tr><td>2 Irrigation</td><td>6 Oil Field Water Supply</td><td>☒ 10 Monitoring Well</td></tr><tr><td>3 Feedlot</td><td>7 Lawn and Garden (domestic)</td><td>11 Injection Well</td></tr><tr><td>4 Industrial</td><td>8 Air Conditioning</td><td>12 Other</td></tr></table>	1 Domestic	5 Public Water Supply	9 Dewatering	2 Irrigation	6 Oil Field Water Supply	☒ 10 Monitoring Well	3 Feedlot	7 Lawn and Garden (domestic)	11 Injection Well	4 Industrial	8 Air Conditioning	12 Other
	1 Domestic	5 Public Water Supply	9 Dewatering										
2 Irrigation	6 Oil Field Water Supply	☒ 10 Monitoring Well											
3 Feedlot	7 Lawn and Garden (domestic)	11 Injection Well											
4 Industrial	8 Air Conditioning	12 Other											
	Was a chemical/bacteriological sample submitted to Department? Yes _____ No X												
	If yes, mo/day/yr sample was submitted _____												
	Water Well Disinfected: Yes _____ No X												

5 TYPE OF BLANK CASING USED:										
<table border="0"><tr><td>1 Steel</td><td>3 RMP (SR)</td><td>5 Wrought</td><td>7 Fiberglass</td><td>9 Other (specify below)</td></tr><tr><td>☒ 2 PVC</td><td>4 ABC</td><td>6 Asbestos-Cement</td><td>8 Concrete Tile</td><td>OVERDRILLED 20 FT</td></tr></table>	1 Steel	3 RMP (SR)	5 Wrought	7 Fiberglass	9 Other (specify below)	☒ 2 PVC	4 ABC	6 Asbestos-Cement	8 Concrete Tile	OVERDRILLED 20 FT
1 Steel	3 RMP (SR)	5 Wrought	7 Fiberglass	9 Other (specify below)						
☒ 2 PVC	4 ABC	6 Asbestos-Cement	8 Concrete Tile	OVERDRILLED 20 FT						
Blank casing diameter 2 in. Was casing pulled? Yes _____ No X If yes, how much _____										
Casing height above or below land surface 0 in.										


6 GROUT PLUG MATERIAL:	1 Neat cement	2 Cement grout	☒ 3 Bentonite	4 Other
Grout Plug Intervals From 30.4 ft. to 3 ft. From _____ ft. to _____ ft. From _____ ft. to _____ ft.				

What is the nearest source of possible contamination:

- | | | | |
|--------------------------|-------------------|-------------------------|--------------------------|
| 1 Septic tank | 6 Seepage pit | 11 Fuel storage | 16 Other (specify below) |
| 2 Sewer lines | 7 Pit privy | 12 Fertilizer storage | |
| 3 Watertight sewer lines | 8 Sewage lagoon | 13 Insecticide storage | |
| 4 Lateral lines | 9 Feedyard | 14 Abandoned water well | |
| 5 Cess Pool | 10 Livestock pens | 15 Oil well/ Gas well | |

Direction from well? _____ How many feet? _____

FROM	TO	CODE	PLUGGING MATERIALS
30.4	3		Bentonite chips
3.0	0		cement

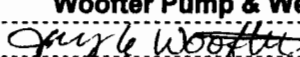7 CONTRACTOR'S OR LANDOWNER'S CERTIFICATION: This water well was plugged under my jurisdiction and was completed on (mo/day/yr) 9-21-2005 and this record is true to the best of my knowledge and belief. Kansas Water Well Contractor's License No. 554 This Water Well Record was completed on (mo/day/yr) 10-14-05 under the business name of Woofter Pump & Well Inc. by (signature) 

INSTRUCTIONS: Please fill in blanks and circle the correct answers. Send three copies to Kansas Department of Health and Environment, Bureau of Water, 1000 S W Jackson St., Ste. 420, Topeka, Kansas 66620-0001. Telephone: 785-296-3565. Send one to Water Well Owner and retain one for your records.