

1 LOCATION OF WATER WELL:	Fraction	Section Number	Township Number	Range Number
County: Reno	NW ¼ NW ¼ NW ¼	18	26	6

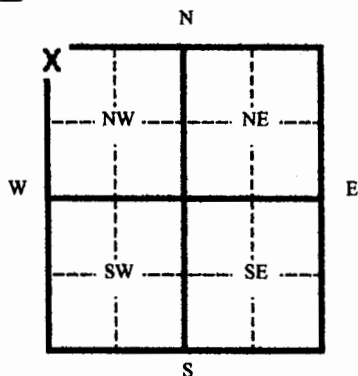
Distance and direction from nearest town or city street address of well if located within city?

McCubbin Oil - Pretty Prairie, Ks

2 WATER WELL OWNER: **Robert Kriesel**
 RR#, St. Address, Box # **124 E. Main St.**
 City, State, ZIP Code : **Pretty Prairie Ks**

Board of Agriculture, Division of Water Resources
 Application Number: **SV-6**

3 MARK WELL'S LOCATON WITH AN "X" IN SECTION BOX:

4 DEPTH OF WELL **29.4** ft.WELL'S STATIC WATER LEVEL **25** ft.

WELL WAS USED AS:

- | | | |
|--------------|------------------------------|--|
| 1 Domestic | 5 Public Water Supply | 9 Dewatering |
| 2 Irrigation | 6 Oil Field Water Supply | ☒ 10 Monitoring Well |
| 3 Feedlot | 7 Lawn and Garden (domestic) | 11 Injection Well |
| 4 Industrial | 8 Air Conditioning | 12 Other |

Was a chemical/bacteriological sample submitted to Department? Yes _____ No ☒

If yes, mo/day/yr sample was submitted _____

Water Well Disinfected: Yes _____ No ☒

5 TYPE OF BLANK CASING USED:

- | | | | | |
|---|------------|-------------------|-----------------|---------------------------|
| 1 Steel | 3 RMP (SR) | 5 Wrought | 7 Fiberglass | 9 Other (specify below) |
| ☒ 2 PVC | 4 ABC | 6 Asbestos-Cement | 8 Concrete Tile | Overdrilled 20 ft. |

Blank casing diameter **2** in. Was casing pulled? Yes _____ No ☒ If yes, how much _____Casing height above or below land surface **0** in.6 GROUT PLUG MATERIAL: 1 Neat cement 2 Cement grout ☒ 3 Bentonite 4 Other _____Grout Plug Intervals From **29.5** ft. to **3** ft. From _____ ft. to _____ ft. From _____ ft. to _____ ft.

What is the nearest source of possible contamination:

- | | | | |
|--------------------------|-------------------|-------------------------|--------------------------|
| 1 Septic tank | 6 Seepage pit | 11 Fuel storage | 16 Other (specify below) |
| 2 Sewer lines | 7 Pit privy | 12 Fertilizer storage | |
| 3 Watertight sewer lines | 8 Sewage lagoon | 13 Insecticide storage | |
| 4 Lateral lines | 9 Feedyard | 14 Abandoned water well | |
| 5 Cess Pool | 10 Livestock pens | 15 Oil well/ Gas well | |

Direction from well? _____

How many feet? _____

FROM	TO	CODE	PLUGGING MATERIALS
28.5	3		Bentonite chips
3.0	0		cement

7 CONTRACTOR'S OR LANDOWNER'S CERTIFICATION: This water well was plugged under my jurisdiction and was completed on (mo/day/yr) **9-21-2005** and this record is true to the best of my knowledge and belief. Kansas Water Well Contractor's License No. **554** This Water Well Record was completed on (mo/day/yr) **10-14-05** under the business name of **Woofert Pump & Well Inc.**
 by (signature) *[Signature]*

INSTRUCTIONS: Please fill in blanks and circle the correct answers. Send three copies to Kansas Department of Health and Environment, Bureau of Water, 1000 S W Jackson St., Ste. 420, Topeka, Kansas 66620-0001. Telephone: 785-296-3565. Send one to Water Well Owner and retain one for your records.