

1 LOCATION OF WATER WELL:	Fraction	Section Number	Township Number	Range Number
County: Reno	NW ¼ NW ¼ NW ¼	18	26	6

Distance and direction from nearest town or city street address of well if located within city?

McCubbin Oil - Pretty Prairie, Ks

2 WATER WELL OWNER: Robert Kriesel	Board of Agriculture, Division of Water Resources
RR#, St. Address, Box # 124 E. Main St.	Application Number: MW-13
City, State, ZIP Code: Pretty Prairie Ks	

3 MARK WELL'S LOCATION WITH AN "X" IN SECTION BOX:

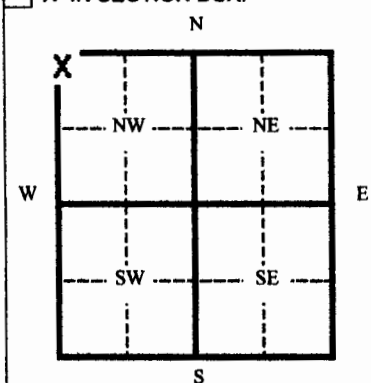
4 DEPTH OF WELL **29** ft.WELL'S STATIC WATER LEVEL **22** ft.

WELL WAS USED AS:

- | | | |
|--------------|------------------------------|--|
| 1 Domestic | 5 Public Water Supply | 9 Dewatering |
| 2 Irrigation | 6 Oil Field Water Supply | ☒ 10 Monitoring Well |
| 3 Feedlot | 7 Lawn and Garden (domestic) | 11 Injection Well |
| 4 Industrial | 8 Air Conditioning | 12 Other |

Was a chemical/bacteriological sample submitted to Department? Yes No ☒

If yes, mo/day/yr sample was submitted

Water Well Disinfected: Yes No ☒

5 TYPE OF BLANK CASING USED:

- | | | | | |
|---|------------|-------------------|-----------------|--------------------------|
| 1 Steel | 3 RMP (SR) | 5 Wrought | 7 Fiberglass | 9 Other (specify below) |
| ☒ 2 PVC | 4 ABC | 6 Asbestos-Cement | 8 Concrete Tile | OVERDRILLED 20 FT |
- Blank casing diameter **2** in. Was casing pulled? Yes No ☒ If yes, how much
- Casing height above or below land surface **0** in.

6 GROUT PLUG MATERIAL:	1 Neat cement	2 Cement grout	☒ 3 Bentonite	4 Other		
Grout Plug Intervals	From 29 ft. to 3 ft.	From	ft. to	ft. From	ft. to	ft.

What is the nearest source of possible contamination:

- | | | | |
|--------------------------|-------------------|-------------------------|--------------------------|
| 1 Septic tank | 6 Seepage pit | 11 Fuel storage | 16 Other (specify below) |
| 2 Sewer lines | 7 Pit privy | 12 Fertilizer storage | |
| 3 Watertight sewer lines | 8 Sewage lagoon | 13 Insecticide storage | |
| 4 Lateral lines | 9 Feedyard | 14 Abandoned water well | |
| 5 Cess Pool | 10 Livestock pens | 15 Oil well/ Gas well | |

Direction from well? How many feet?

FROM	TO	CODE	PLUGGING MATERIALS
29	3		Bentonite chips
3.0	0		cement

7 CONTRACTOR'S OR LANDOWNER'S CERTIFICATION: This water well was plugged under my jurisdiction and was completed on (mo/day/yr) 9-22-2005 and this record is true to the best of my knowledge and belief. Kansas Water Well Contractor's License No. 554 This Water Well Record was completed on (mo/day/yr) 10-14-05 under the business name of Woofert Pump & Well Inc. by (signature) <i>[Signature]</i>

INSTRUCTIONS: Please fill in blanks and circle the correct answers. Send three copies to Kansas Department of Health and Environment, Bureau of Water, 1000 S W Jackson St., Ste. 420, Topeka, Kansas 66620-0001. Telephone: 785-296-3565. Send one to Water Well Owner and retain one for your records.