

WATER WELL PLUGGING RECORD Form WWC-5P

KSA 82a-1212

ID NO.

CPB-12

1 LOCATION OF WATER WELL: County: RENO Street/Rural Address of Well Location; if unknown, distance & direction from nearest town or intersection: If at owner's address, check here ☐ 2230' N AND 78' EAST OF SW CORNER OF SEC 1 HWY 17 & SUN CITY ROAD	Fraction 1/4 NW 1/4 NW 1/4 SW 1/4 Section Number 1 Township Number T 26 S Range Number 6 ☐ E ☒ W	Global Positioning Systems (GPS) information: Latitude: 37.81273 (in decimal degrees) Longitude: -97.93612 (in decimal degrees) Elevation: 1474 Datum: ☒ WGS84, ☐ NAD83, ☐ NAD27 Collection Method: ☒ GPS unit (Make/Model: GARMIN GPSmap 60CSx) ☐ Digital Map/Photo, ☒ Topographic Map, ☐ Land Survey Est. Accuracy: ☐ < 3 m, ☐ 3-5 m, ☒ 5-15 m, ☐ > 15 m
2 WATER WELL OWNER: ONEOK HYDROCARBON RR#, St. Address, Box #: P.O. BOX 29 City, State ZIP Code: MEDFORD OK., 73759		

3 MARK WELL'S LOCATION WITH AN "X" IN SECTION BOX: 	4 DEPTH OF WELL 250' ft. WELL'S STATIC WATER LEVEL _____ ft. WELL WAS USED AS: ☐ Domestic ☐ Irrigation ☐ Feedlot ☐ Industrial ☐ Public Water Supply ☐ Oil Field Water Supply ☐ Domestic (Lawn & Garden) ☐ Air Conditioning ☐ Dewatering ☐ Monitoring ☐ Injection Well ☒ Other CATH. PROT. Was a chemical/bacteriological sample submitted to Department? Yes ☐ No ☒
---	--

5 TYPE OF BLANK CASING USED:

☒ Steel ☐ RMP (SR) ☐ Wrought ☐ Fiberglass ☐ Other (Specify below) _____
☒ PVC ☐ ABS ☐ Asbestos-Cement ☐ Concrete Tile

Blank casing diameter **10** in. Was casing pulled? Yes ☐ No ☒ If yes, how much _____

Casing height above or below land surface **BELOW 48** in.

6 GROUT PLUG MATERIAL: ☐ Neat cement ☐ Cement grout ☒ Bentonite ☒ Other **TREATED PELLETS**

Grout Plug Intervals: From **4** ft. to **38+/-** ft., From _____ ft. to _____ ft., From _____ to _____ ft.

What is the nearest source of possible contamination:

☐ Septic tank	☐ Seepage pit	☐ Fuel Storage	☒ Other (specify below) POND
☐ Sewer lines	☐ Pit privy	☐ Fertilizer storage	
☐ Watertight sewer lines	☐ Sewage lagoon	☐ Insecticide storage	
☐ Lateral lines	☐ Feedyard	☐ Abandoned water well	
☐ Cess pool	☐ Livestock pens	☐ Oil well/Gas well	


Direction from well? **EAST**
How many feet? **70' TO 100'**

FROM	TO	PLUGGING MATERIALS	FROM	TO	PLUGGING MATERIALS
4'	250'	VENT PLUG W/BENTONITE HP			CATHODIC PROTECTION BORE HOLE
4'	38+/-	10" CS W/ BENONITE HOLE PLUG			ALL FILLED WITH TREATED PELLETS

7 CONTRACTOR'S OR LANDOWNER'S CERTIFICATION: This water well was plugged under my jurisdiction and was completed on (mo/day/year) **10-6-09** and this record is true to the best of my knowledge and belief. Kansas Water Well Contractor's License No. **134**. This Water Well Record was completed on (mo/day/year) **4-25-13** under the business name of **ONEOK HYDROCARBON, LLC** by (signature) *Donna L. Wells*

INSTRUCTIONS: Use typewriter or ballpoint pen. Please press firmly and print clearly. Please fill in blanks, underline or circle the correct answers. Send top three copies to Kansas Department of Health and Environment, Bureau of Water, Geology Section, 1000 SW Jackson St., Ste. 420, Topeka, Kansas 66612-1367. Telephone: 785/296-5524. Send one to Water Well Owner and retain one for your records. Visit us at <http://www.kdheks.gov/waterwell/index.html>.

Check one: ☒ White Copy ☐ Blue Copy ☐ Pink Copy

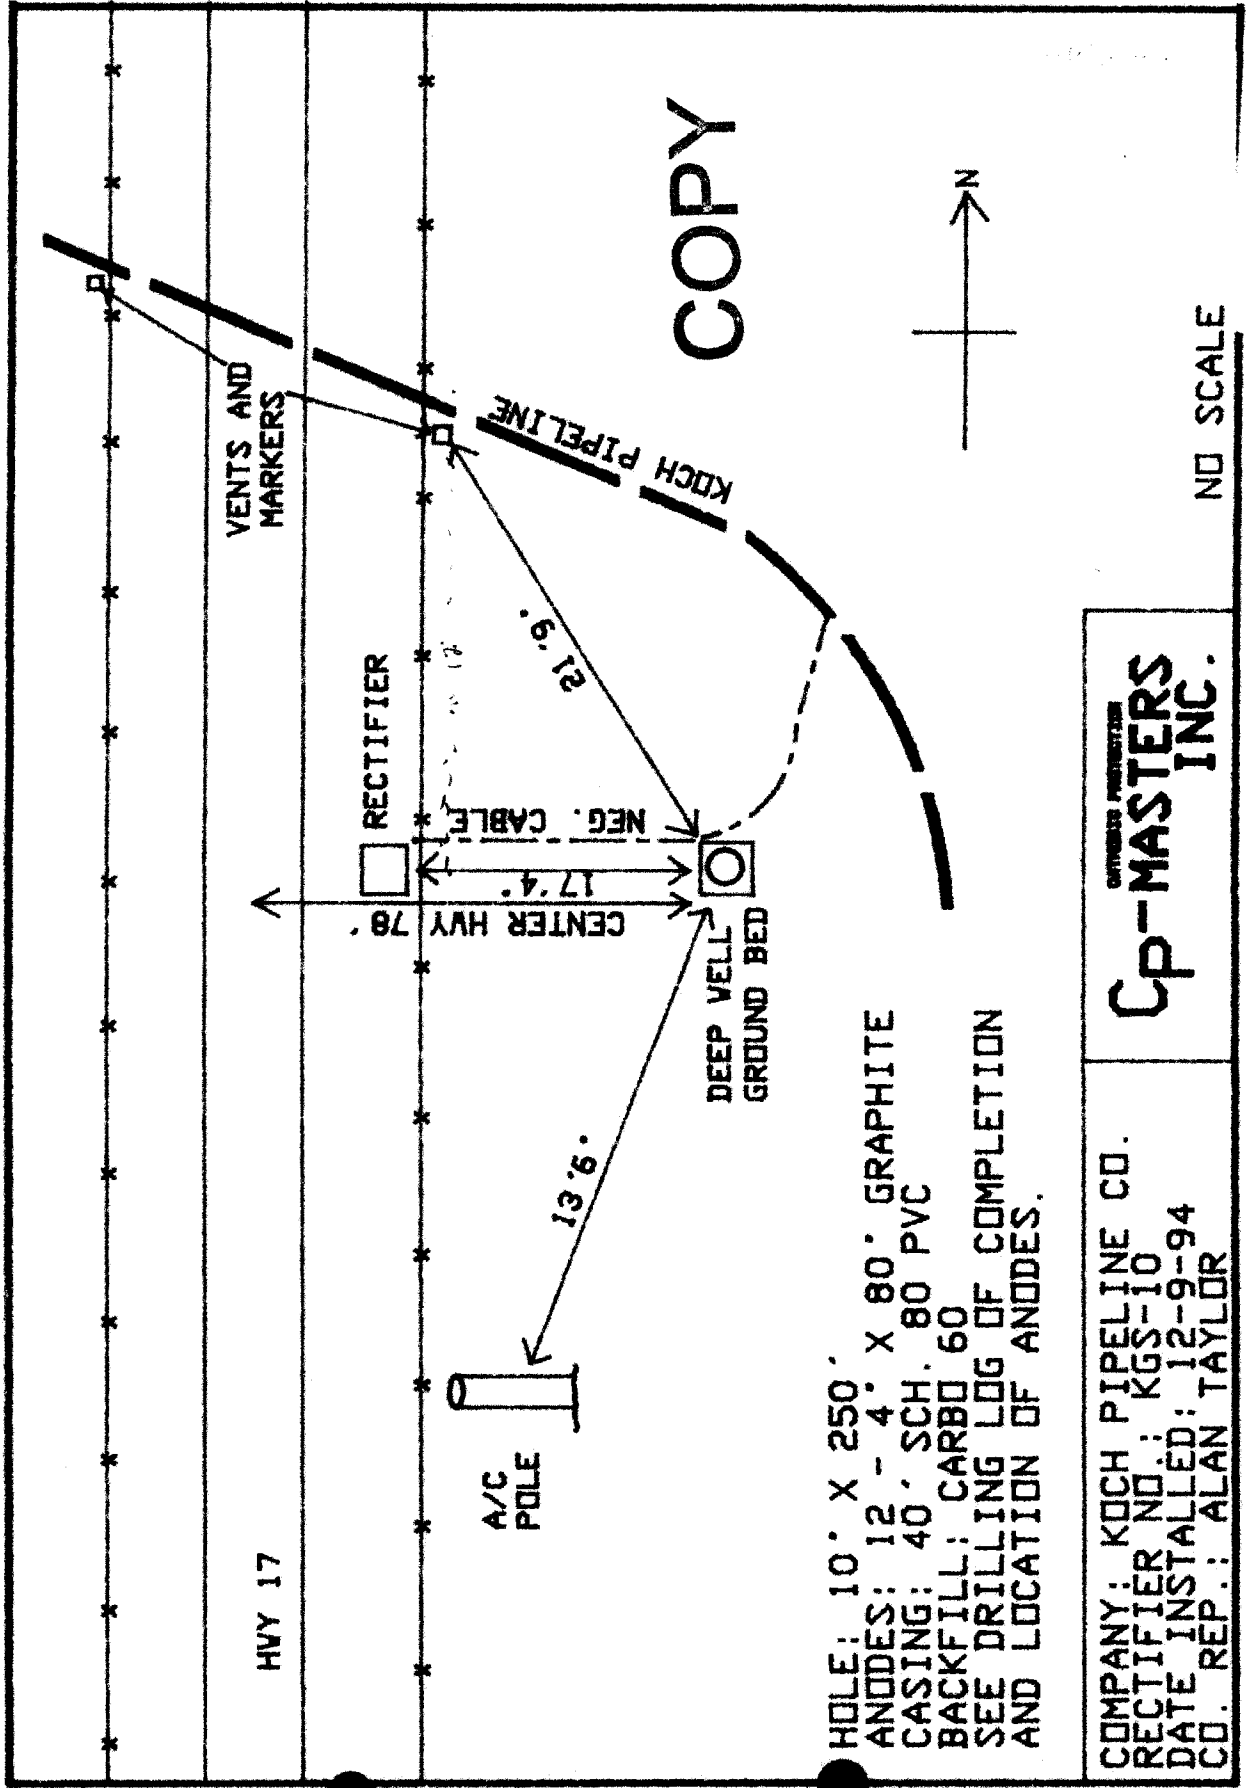

COMPANY: KOCH PIPELINE CO.
RECTIFIER NO.: KGS-10
DATE INSTALLED: 12-9-94
CO. REP.: ALAN TAYLOR

Cp-MASTERS
INC.

NO SCALE

KMC00000574

KOCH

KOCH TRANSPORTATION
AND OPERATIONS SERVICES
CORROSION SERVICES GROUP

CALCULATIONS AND SKETCHES

CPB-12

DATE 10/3/94

SHEET 1 OF 1

SUBJECT DEEP Groundbed: RENO County


JOB NO. _____

SI T26S R6W

BY DCS

NOT TO SCALE

CHKD _____

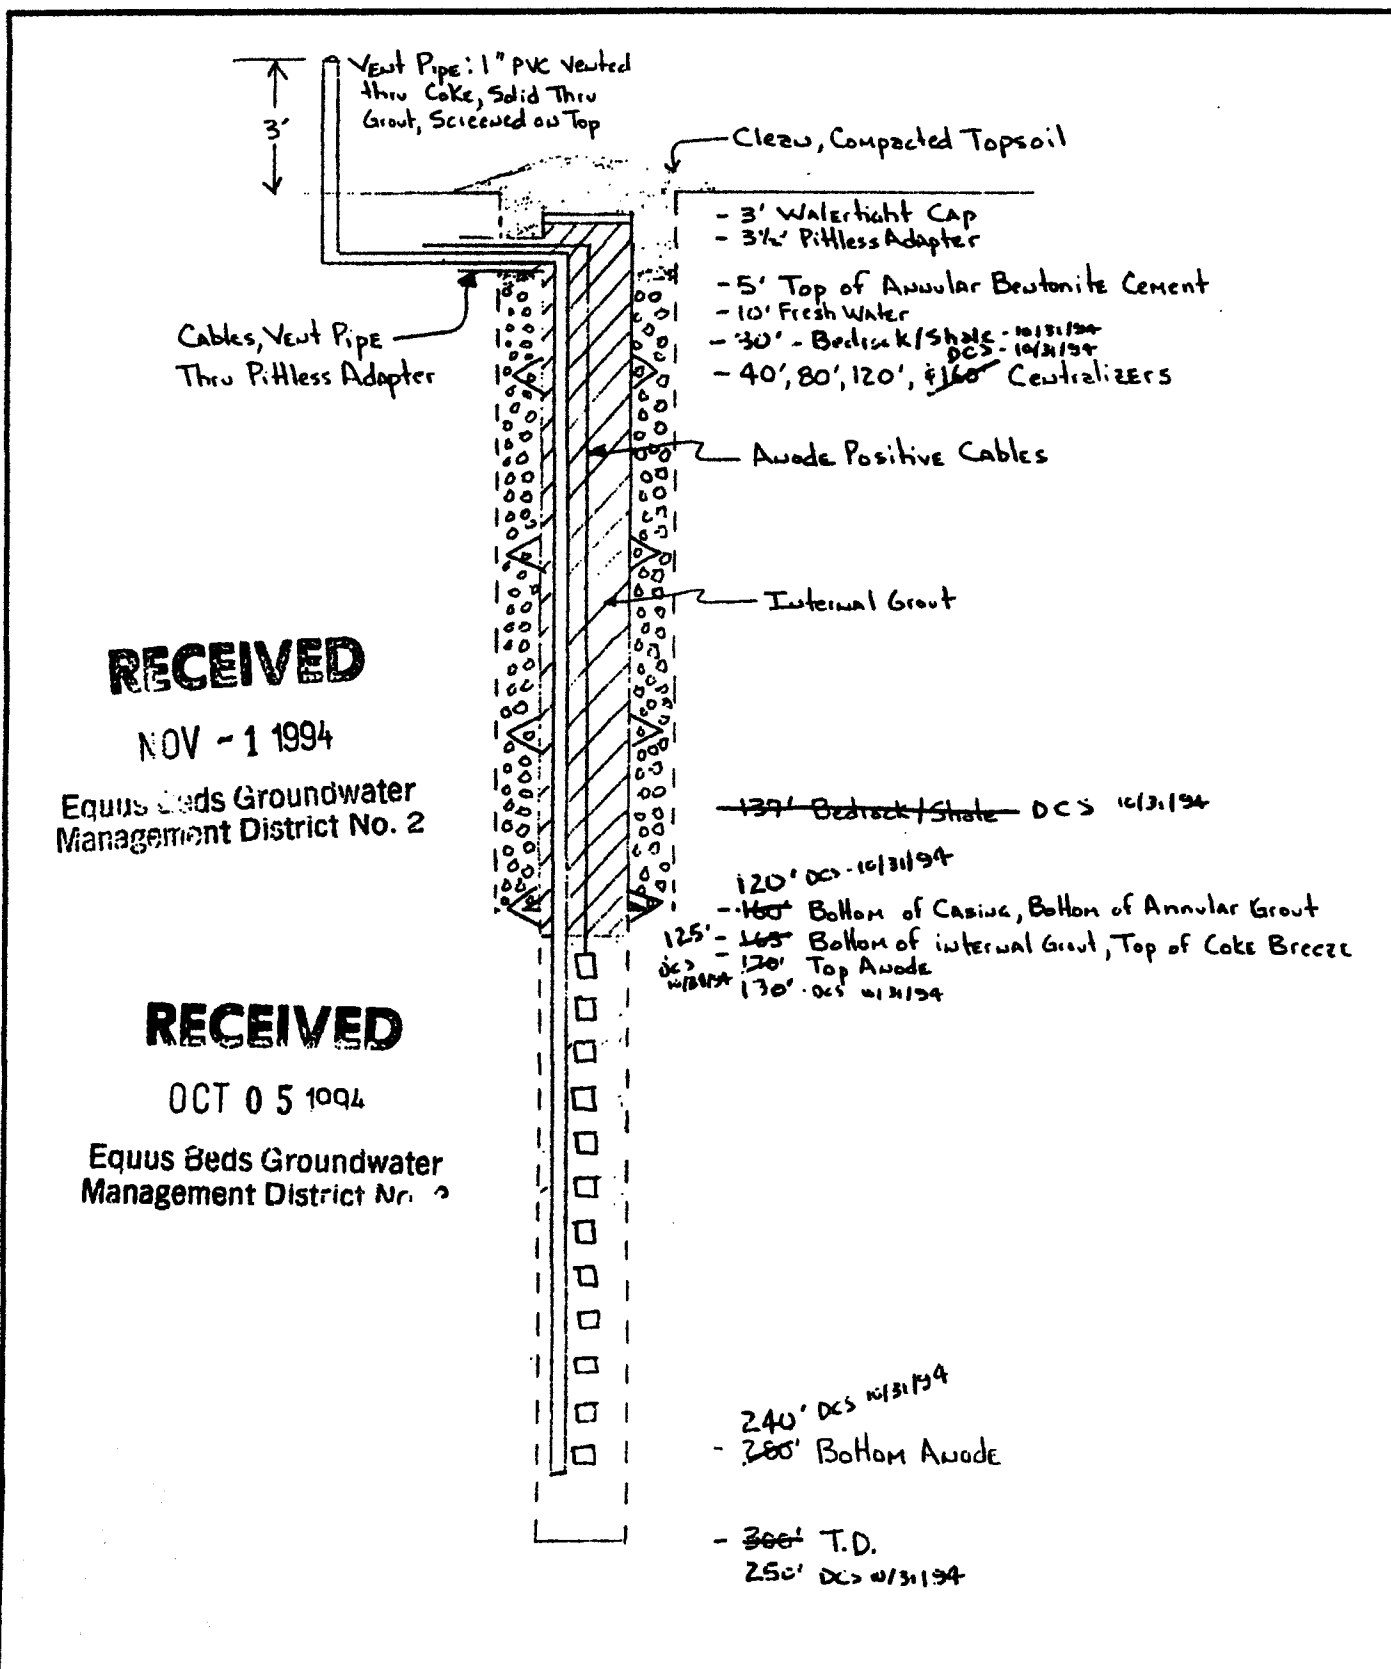

CP-MASTERS, INC

P.O. BOX 5595

EDMOND, OKLA. 73043

PHONE: 405-330-1550

FAX No.: 405-330-1553

COMPANY: KOCH PIPELINE CO.

COMPANY REP. ALAN TAYLOR

LOCATION: HUTCHISON, KS

RECTIFIER # KGS-10

DRILLER:

CP-MASTERS

DEEPWELL DATA

CASING: SCH 80 DIA. HOLE 10"
 DIAMETER: 10" DEPTH: 250'
 CASING DEPTH: 40' COKE TYPE CARBO B
 NUMBER OF ANODES: 12 DATE: 12-9-94
 ANODE TYPE: GRAPHITE LOG VOLT 13.5
 ANODE LEAD TYPE: HMMPE SOURCE BATTERY

DEPTH FT.	DRILLER'S LOG	FT	ANODE NO.	NATIVE	W/COKE	ELECTRIC LOG W/COKE
0	0 - 40' CASING					
10						
20						
30						
40						
50				0.1		
60				0.2		
70				0.2		
80				0.2		
90				0.2		
100				0.2		5.0
110				0.2		4.9
120				0.2		5.1
130				0.2		4.9
140				0.2		4.8
150				0.2		4.7
160				0.2		4.2
170				0.2		4.5
180				0.2		4.6
190				0.2		4.5
200				0.2		4.5
			12			13.7
			11			12.3
			10			13.5
			9			13.0
			8	4.4		12.6
			7	4.4		13.3
			6	4.1		13.3
			5	4.9		14.0
			4	4.3		13.0
				3.7		
				4.6		
				4.8		
				4.8		

DEPTH FT.	DRILLER'S LOG	FT	ANODE NO.	NATIVE	W/COKE	ELECTRIC LOG W/COKE
210				4.6		4.6
220			3	4.6		4.6
230			2	4.3		4.3
240			1	4.5		4.4
250				4.8		4.4

COPY

KMC000000573