

0W4-1

WATER WELL RECORD


Form WWC-5

Division of Water Resources App. No.

1 LOCATION OF WATER WELL: County: Reno Fraction SE 1/4 NE 1/4 SE 1/4 SW 1/4 Section Number 18 Township No. T 26 S Range Number R 6 E W

Street/Rural Address of Well Location; if unknown, distance & direction from nearest town or intersection: If at owner's address, check here. Global Positioning System (GPS) information: Latitude: 37.77930 Longitude: 098.01939 Elevation: 1551

2 WATER WELL OWNER: City of Pretty Prairie RR#, Street Address, Box #: 119 W. Main Street City, State, ZIP Code : Pretty Prairie, Kansas 67570 Collection Method: GPS unit (Make/Model: Garmin 62S)

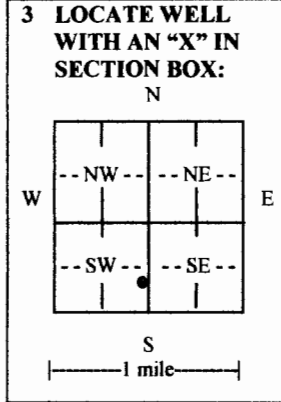

3 LOCATE WELL WITH AN 'X' IN SECTION BOX: 4 DEPTH OF COMPLETED WELL 78 ft. Depth(s) Groundwater Encountered (1) (2) (3). WELL'S STATIC WATER LEVEL 35.62 ft. below land surface measured on mo/day/yr. 5/26/2015. Pump test data: Well water was... EST. YIELD... Bore Hole Diameter 7 in. to 67 ft. WELL WATER TO BE USED AS: Monitoring well. Was a chemical/bacteriological sample submitted to Department? No. Water well disinfected? Yes

5 TYPE OF CASING USED: PVC CASING JOINTS: Glued Casing diameter 2 in. to 67 ft. Casing height above land surface 36 in. TYPE OF SCREEN OR PERFORATION MATERIAL: PVC SCREEN OR PERFORATION OPENINGS ARE: Saw cut SCREEN-PERFORATED INTERVALS: From 67 ft. to 78 ft. GRAVEL PACK INTERVALS: From 78 ft. to 54 ft.

6 GROUT MATERIAL: Bentonite Grout Intervals: From 54 ft. to 2 ft. What is the nearest source of possible contamination: None

Table with columns: FROM, TO, LITHOLOGIC LOG, FROM, TO, LITHO. LOG (cont.) or PLUGGING INTERVALS. Rows include Top soil, Small sand w/strks of tan clay, Small sand, Small-med. sand, Small-med. sand w/strks of tan clay, Red bed.

7 CONTRACTOR'S OR LANDOWNER'S CERTIFICATION: This water well was constructed, reconstructed, or plugged under my jurisdiction and was completed on (mo/day/year) 5/26/2015 and this record is true to the best of my knowledge and belief. Kansas Water Well Contractor's License No. 134. This Water Well Record was completed on (mo/day/year) 6/2/2015 under the business name of Rosencrsantz-Bemis Ent. by (signature)

INSTRUCTIONS: Use typewriter or ball point pen. PLEASE PRESS FIRMLY and PRINT clearly. Please fill in blanks and check the correct answers. Send three copies (white, blue, pink) to Kansas Department of Health and Environment, Bureau of Water, Geology Section, 1000 SW Jackson St., Suite 420, Topeka, Kansas 66612-1367. Telephone 785-296-5524. Send one copy to WATER WELL OWNER and retain one for your records. Include fee of \$5.00 for each constructed well. Visit us at http://www.kdheks.gov/waterwell/index.html.