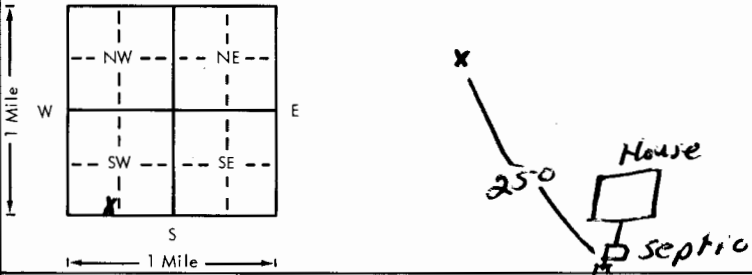


USE TYPEWRITER OR BALL
POINT PEN-PRESS FIRMLY,
PRINT CLEARLY.

WATER WELL RECORD
KSA 82a-1201-1215

Kansas Department of Health and
Environment-Division of Environment
(Water well Contractors)
Topeka, Kansas 66620

1. Location of well:		County Reno	Fraction SE 1/4 SW 1/4 SW 1/4	Section number 3	Township number T 26 S R 6 E	Range number 6 E
2. Distance and direction from nearest town or city: Street address of well location if in city:		2 mi. N, 3 E of pretty Prairie		3. Owner of well: Lonnie Graber R.R. or street: AD1 City, state, zip code: Pretty Prairie, KS 67570		
4. Locate with "X" in section below: N W E S 1 Mile		Sketch map: 		6. Bore hole dia. 12 1/2 in. Completion date 5-4-79 Well depth 80 ft.		
5. Type and color of material		From	To	7. ☒ Cable tool ☒ Rotary ☐ Driven ☐ Dug ☐ Hollow rod ☐ Jetted ☐ Bored ☐ Reverse rotary		
Brown Sand		0	15	8. Use: ☐ Domestic ☐ Public supply ☐ Industry ☐ Irrigation ☐ Air conditioning ☐ Stock ☒ Lawn ☐ Oil field water ☐ Other		
Red + Blue Shale		15	80	9. Casing: Material PIST Height: Above or below Threaded ☐ Welded ☐ Surface 12 in. RMP ☒ PVC ☐ Weight 3 lbs./ft. Dia. 8 in. to 20 ft. depth Wall Thickness: inches or Dia. ☐ in. to ☐ ft. depth gage No. 1250		
				10. Screen: Manufacturer's name None Used Type ☐ Dia. ☐ Slot/gauze ☐ Length ☐ Set between ☐ ft. and ☐ ft. ☐ ft. and ☐ ft. Gravel pack? ☐ Size range of material ☐		
				11. Static water level: ☐ mo./day/yr. 6 ft. below land surface Date 5-4-79		
				12. Pumping level below land surfaces: 7 ft. after 1 hrs. pumping 25 g.p.m. ☐ ft. after ☐ hrs. pumping ☐ g.p.m. Estimated maximum yield 50 g.p.m.		
				13. Water sample submitted: ☐ mo./day/yr. ☐ Yes ☒ No Date ☐		
				14. Well head completion: ☐ Pitless adapter 12 Inches above grade		
				15. Well grouted? Yes With: ☐ Neat cement ☒ Bentonite ☐ Concrete Depth: From 3 ft. to 13 ft.		
				16. Nearest source of possible contamination: ft. 250 Direction SE Type Septic Well disinfected upon completion? ☒ Yes ☐ No		
				17. Pump: ☒ Not installed Manufacturer's name ☐ Model number ☐ HP ☐ Volts ☐ Length of drop pipe ☐ ft. capacity ☐ g.p.m. Type: ☐ Submersible ☐ Turbine ☐ Jet ☐ Reciprocating ☐ Centrifugal ☐ Other		
		(Use a second sheet if needed)				
18. Elevation:		19. Remarks:		20. Water well contractor's certification: This well was drilled under my jurisdiction and this report is true to the best of my knowledge and belief. Miller Water Well 137 Business name Hutchinson, KS License No. ☐ Address Ego Miller Date 5-4-79 Signed Ego Miller Authorized representative		
Topography: ☐ Hill ☒ Slope ☐ Upland ☐ Valley						

Forward the white, blue and pink copies to the Department of Health and Environment

Form WWC-5