GMS-EB-516-C

WATER WELL RECORD Form WWC-5 KSA 82a-1212

1 LOCATION OF WATER WELL:

County: Reno

Fraction: SE ¼ ~~SW~~ NE ¼ ~~SW~~ NE ¼

Section Number: 11

Township Number: T 26 S

Range Number: R 6 E/W

Distance and direction from nearest town or city street address of well if located within city?

Approximately 2 Miles North and 4 1/4 Miles East of Pretty Prairie

2 WATER WELL OWNER: Equus Beds GMD #2

RR#, St. Address, Box # : 313 Spruce

City, State, ZIP Code : Halstead, KS 67056-1925

Board of Agriculture, Division of Water Resources Application Number:

3 LOCATE WELL'S LOCATION WITH AN "X" IN SECTION BOX:

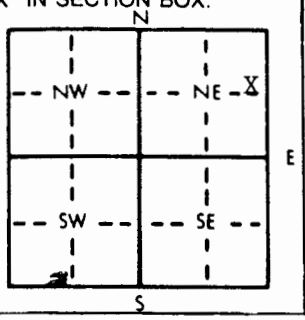

4 DEPTH OF COMPLETED WELL 27 ft. ELEVATION: Unknown

Depth(s) Groundwater Encountered 1. ..... ft. 2. ..... ft. 3. ..... ft.

WELL'S STATIC WATER LEVEL 20 ft. below land surface measured on mo/day/yr 2-14-92

Pump test data: Well water was not ch'd ft. after ..... hours pumping ..... gpm

Est. Yield unknown gpm: Well water was ..... ft. after ..... hours pumping ..... gpm

Bore Hole Diameter 6 1/4 in. to 28 ft., and ..... in. to ..... ft.

WELL WATER TO BE USED AS: 1 Domestic 2 Irrigation 3 Feedlot 4 Industrial 5 Public water supply 6 Oil field water supply 7 Lawn and garden only 8 Air conditioning 9 Dewatering 10 Monitoring well 11 Injection well 12 Other (Specify below)

Was a chemical/bacteriological sample submitted to Department? Yes ..... No X; If yes, mo/day/yr sample was submitted

Water Well Disinfected? Yes ..... No X

5 TYPE OF BLANK CASING USED: 1 Steel 2 PVC 3 RMP (SR) 4 ABS 5 Wrought iron 6 Asbestos-Cement 7 Fiberglass 8 Concrete tile 9 Other (specify below)

CASING JOINTS: Glued X Clamped ..... Welded ..... Threaded X

Blank casing diameter Steel 2 in. to 7 ft., Dia PVC 2 in. to 19 ft., Dia ..... in. to ..... ft.

Casing height above land surface Steel 36 in., weight Steel 3.65/PVC .70 lbs./ft. Wall thickness or gauge No. .154

TYPE OF SCREEN OR PERFORATION MATERIAL: 1 Steel 2 Brass 3 Stainless steel 4 Galvanized steel 5 Fiberglass 6 Concrete tile 7 PVC 8 RMP (SR) 9 ABS 10 Asbestos-cement 11 Other (specify) ..... 12 None used (open hole)

SCREEN OR PERFORATION OPENINGS ARE: 1 Continuous slot 2 Louvered shutter 3 Mill slot 4 Key punched 5 Gauzed wrapped 6 Wire wrapped 7 Torch cut 8 Saw cut 9 Drilled holes 10 Other (specify) ..... 11 None (open hole)

SCREEN-PERFORATED INTERVALS: From 19 ft. to 24 ft., From ..... ft. to ..... ft.
From ..... ft. to ..... ft., From ..... ft. to ..... ft.

GRAVEL PACK INTERVALS: From 18 ft. to 28 ft., From ..... ft. to ..... ft.
From ..... ft. to ..... ft., From ..... ft. to ..... ft.

6 GROUT MATERIAL: 1 Neat cement 2 Cement grout 3 Bentonite 4 Other Bentonite Holeplug

Grout Intervals: From ..... ft. to ..... ft., From ..... ft. to ..... ft., From 0 ft. to 18 ft.

What is the nearest source of possible contamination:
1 Septic tank 2 Sewer lines 3 Watertight sewer lines 4 Lateral lines 5 Cess pool 6 Seepage pit 7 Pit privy 8 Sewage lagoon 9 Feedyard 10 Livestock pens 11 Fuel storage 12 Fertilizer storage 13 Insecticide storage 14 Abandoned water well 15 Oil well/Gas well 16 Other (specify below) None Known

Direction from well? How many feet?

FROM	TO	LITHOLOGIC LOG	FROM	TO	PLUGGING INTERVALS
0	4	Topsoil			
4	5	Clay, red			
5	24	Sand and gravel, fine, medium, coarse, loose, clean			
24	28	Shale, red, green, hard			

7 CONTRACTOR'S OR LANDOWNER'S CERTIFICATION: This water well was (1) constructed, (2) reconstructed, or (3) plugged under my jurisdiction and was completed on (mo/day/year) 2-14-92 and this record is true to the best of my knowledge and belief. Kansas Water Well Contractor's License No. 185 This Water Well Record was completed on (mo/day/yr) 2-28-92 under the business name of Clarke Well & Equipment, Inc. by (signature) Darrell W. Clarke

INSTRUCTIONS: Use typewriter or ball point pen. *PLEASE PRESS FIRMLY* and *PRINT* clearly. Please fill in blanks, underline or circle the correct answers. Send top three copies to Kansas Department of Health and Environment, Bureau of Water, Topeka, Kansas 66620-0001. Telephone: 913-296-5545. Send one to WATER WELL OWNER and retain one for your records.