

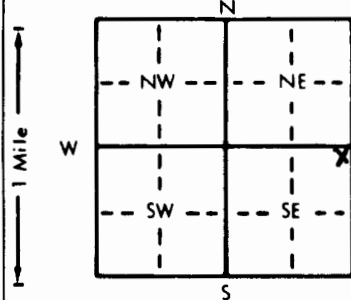
1 LOCATION OF WATER WELL:	Fraction	Section Number	Township Number	Range Number
County: <u>Reno</u>	<u>NE 1/4 NE 1/4 SE 1/4</u>	<u>15</u>	T <u>26</u> S	R <u>6</u> EW

Distance and direction from nearest town or city street address of well if located within city?

3 miles E, 1/2 mile N of Pretty Prairie, Kansas

2 WATER WELL OWNER:	RR#, St. Address, Box #	City, State, ZIP Code	Board of Agriculture, Division of Water Resources
<u>Paul Kemp</u>	<u>23515 S. Valley Pride</u>	<u>Pretty Prairie, KS 67570</u>	Application Number:

3 LOCATE WELL'S LOCATION WITH AN "X" IN SECTION BOX:	4 DEPTH OF COMPLETED WELL	ELEVATION:
--	---------------------------	------------

Depth(s) Groundwater Encountered 11 ft. 2. ft. 3. ft.WELL'S STATIC WATER LEVEL 11 ft. below land surface measured on mo/day/yr 11-20-96

Pump test data: Well water was ft. after hours pumping gpm

Est. Yield gpm: Well water was ft. after hours pumping gpm

Bore Hole Diameter . in. to . ft., and . in. to . ft.

WELL WATER TO BE USED AS: 5 Public water supply 8 Air conditioning 11 Injection well

1 Domestic 3 Feedlot 6 Oil field water supply 9 Dewatering 12 Other (Specify below)

2 Irrigation 4 Industrial 7 Lawn and garden only 10 Monitoring well StockWas a chemical/bacteriological sample submitted to Department? Yes No X; If yes, mo/day/yr sample was submittedWater Well Disinfected? Yes X No

5 TYPE OF BLANK CASING USED:	5 Wrought iron	8 Concrete tile	CASING JOINTS: Glued <u>X</u> Clamped
------------------------------	----------------	-----------------	---------------------------------------

1 Steel 3 RMP (SR) 6 Asbestos-Cement 9 Other (specify below) Welded

2 PVC 4 ABS 7 Fiberglass ThreadedBlank casing diameter 5 in. to 30 ft., Dia. in. to . ft., Dia. in. to . ft.Casing height above land surface 18 in., weight 1600 lbs./ft. Wall thickness or gauge No. 214

TYPE OF SCREEN OR PERFORATION MATERIAL:	<u>7 PVC</u>	10 Asbestos-cement
---	--------------	--------------------

1 Steel 3 Stainless steel 5 Fiberglass 8 RMP (SR) 11 Other (specify)

2 Brass 4 Galvanized steel 6 Concrete tile 9 ABS 12 None used (open hole)

SCREEN OR PERFORATION OPENINGS ARE:	5 Gauzed wrapped	<u>8 Saw cut</u>	11 None (open hole)
-------------------------------------	------------------	------------------	---------------------

1 Continuous slot 3 Mill slot 6 Wire wrapped 9 Drilled holes

2 Louvered shutter 4 Key punched 7 Torch cut 10 Other (specify)

SCREEN-PERFORATED INTERVALS:	From <u>30</u> ft. to <u>40</u> ft., From . ft. to . ft.
------------------------------	--

From . ft. to . ft., From . ft. to . ft.

GRAVEL PACK INTERVALS: From 40 ft. to 18 ft., From . ft. to . ft.

From . ft. to . ft., From . ft. to . ft.

6 GROUT MATERIAL:	1 Neat cement	2 Cement grout	3 Bentonite	<u>4 Other</u> <u>Hole plug</u>
-------------------	---------------	----------------	-------------	---------------------------------

Grout Intervals: From 18 ft. to 0 ft., From . ft. to . ft., From . ft. to . ft.

What is the nearest source of possible contamination:

1 Septic tank 4 Lateral lines 7 Pit privy 10 Livestock pens 14 Abandoned water well

2 Sewer lines 5 Cess pool 8 Sewage lagoon 11 Fuel storage 15 Oil well/Gas well

3 Watertight sewer lines 6 Seepage pit 9 Feedyard 12 Fertilizer storage 16 Other (specify below)

13 Insecticide storage

Direction from well?	<u>Southeast</u>	How many feet?	<u>600</u>
----------------------	------------------	----------------	------------

FROM	TO	LITHOLOGIC LOG	FROM	TO	PLUGGING INTERVALS
------	----	----------------	------	----	--------------------

0 3 Sandy Top Soil3 8 Brown Silty Clay8 40 Sand + Gravel with pieces of clay40 41 Red Bed

7 CONTRACTOR'S OR LANDOWNER'S CERTIFICATION:	This water well was (1) constructed, (2) reconstructed, or (3) plugged under my jurisdiction and was completed on (mo/day/year) <u>11-20-96</u> and this record is true to the best of my knowledge and belief. Kansas
--	--

Water Well Contractor's License No. 134 This Water Well Record was completed on (mo/day/yr) 11-23-96under the business name of Rosenkrantz-Bemis Ent Inc by (signature) Drug Dodson