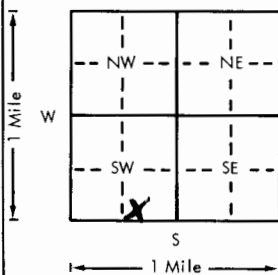
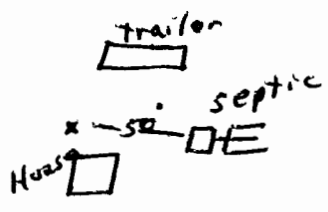


USE TYPEWRITER OR BALL-
POINT PEN-PRESS PROMPTLY,
PRINT CLEARLY.

WATER WELL RECORD
KSA 82a-1201-1215

Kansas Department of Health and
Environment-Division of Environment
(Water well Contractors)
Topeka, Kansas 66620

1. Location of well:		County Reno	Fraction SW 1/4 SE 1/4 SW 1/4	Section number 15	Township number T 26 S	Range number R 6 E
2. Distance and direction from nearest town or city: Street address of well location if in city:		3. Owner of well: Homer Graber R.R. or street: Rd 1 City, state, zip code: Pretty Prairie, KS 67570				
4. Locate with "X" in section below: 		Sketch map: 		6. Bore hole dia. 10 in. Completion date Well depth 45 ft. 6-5-79		
5. Type and color of material		From	To	7. ☒ Cable tool ☒ Rotary ☐ Driven ☐ Dug ☐ Hollow rod ☐ Jetted ☐ Bored ☐ Reverse rotary		
Sandy Brown Silt		0	5	8. Use: ☒ Domestic ☐ Public supply ☐ Industry ☐ Irrigation ☐ Air conditioning ☐ Stock ☐ Lawn ☐ Oil field water ☐ Other		
Brown Fine to Course Sand		5	50	9. Casing: Material 115 Height: above or below Threaded ☐ Welded ☐ Surface 12 in. RMP ☒ PVC ☐ Weight 1.95 lbs./ft. Dia. 6 in. to 45 ft. depth Wall Thickness: inches or Dia. ☐ in. to ☐ ft. depth gage No. 200		
				10. Screen: Manufacturer's name Sunflower Type RMP Dia. 6 D gauge .035 Length 10 Set between 35 ft. and 45 ft. ft. and ☐ ft. Gravel pack? Yes Size range of material F-1/2		
				11. Static water level: ☐ mo./day/yr. 27 ft. below land surface Date 4-27-79		
				12. Pumping level below land surfaces: 27 ft. after 2 hrs. pumping 20 g.p.m. ft. after ☐ hrs. pumping ☐ g.p.m. Estimated maximum yield 40 g.p.m.		
				13. Water sample submitted: ☐ mo./day/yr. ☐ Yes ☒ No Date ☐		
				14. Well head completion: ☒ Pitless adapter ☐ Inches above grade		
				15. Well grouted? Yes With: ☒ Neat cement ☐ Bentonite ☐ Concrete Depth: From 3 ft. to 13 ft.		
				16. Nearest source of possible contamination: ft. 50 Direction E Type Septic Well disinfected upon completion? ☒ Yes ☐ No		
				17. Pump: ☐ Not installed Manufacturer's name Valley Steel Model number 51208 HP 1/2 Volts 230 Length of drop pipe 30 ft. capacity 12 g.p.m. Type: ☒ Submersible ☐ Turbine ☐ Jet ☐ Reciprocating ☐ Centrifugal ☐ Other		
18. Elevation:		19. Remarks:		20. Water well contractor's certification: This well was drilled under my jurisdiction and this report is true to the best of my knowledge and belief. Miller Water Well 137 Business name Miller License No. 137 Address Hutchinson, KS Signed Eva Miller Date 7-5-79 Authorized representative		

Forward the white, blue and pink copies to the Department of Health and Environment

Form WWC-5