


1 LOCATION OF WATER WELL:	Fraction	Section Number	Township Number	Range Number
County: Reno	NE ¼ SW ¼ SW ¼	18	T 26 S	R 06 W E/W

Distance and direction from nearest town or city street address of well if located within city?
600 Block on West Main Street, Pretty Prairie, Kansas

2	WATER WELL OWNER:	City of Pretty Prairie	
	RR#, St. Address, Box # :	119 W. Main	Board of Agriculture, Division of Water Resources
	City, State, ZIP Code :	Pretty Prairie, Kansas 67570	Application Number:

3. LOCATE WELL'S LOCATION WITH AN "X" IN SECTION BOX:  4. DEPTH OF COMPLETED WELL: 20 ft. ELEVATION: 22 ft.

Depth(s) Groundwater Encountered 1. 10 ft. 2. 15 ft. 3. 20 ft.

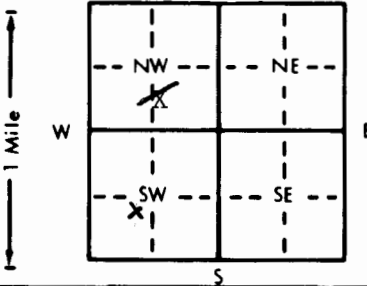

4 DEPTH OF COMPLETED WELL: 20 ft. ELEVATION: _____

Depth(s) Groundwater Encountered 1. _____ ft. 2. _____ ft. 3. _____ ft.

WELL'S STATIC WATER LEVEL: 3 ft. below land surface measured on mo/day/yr _____

Pump test data: Well water was _____ ft. after _____ hours pumping _____ gpm

Est. Yield _____ gpm: Well water was _____ ft. after _____ hours pumping _____ gpm

Bore Hole Diameter _____ in. to _____ ft., and _____ in. to _____ ft.

WELL WATER TO BE USED AS: XX5 Public water supply 8 Air conditioning 11 Injection well

1 Domestic 3 Feedlot 6 Oil field water supply 9 Dewatering 12 Other (Specify below)

2 Irrigation 4 Industrial 7 Lawn and garden only 10 Monitoring well _____

Was a chemical/bacteriological sample submitted to Department? Yes _____ No _____; If yes, mo/day/yr sample was submitted _____

Water Well Disinfected? Yes _____ No _____

5	TYPE OF BLANK CASING USED:		5 Wrought iron	8 Concrete tile	CASING JOINTS: Glued Clamped Welded Threaded. <u>XX</u>
	<u>X</u> Steel	3 RMP (SR)	6 Asbestos-Cement	9 Other (specify below)	
	2 PVC	4 ABS	7 Fiberglass		

Blank casing diameter 12 in. to . ft. Dia. . in. to . ft. Dia. . in. to . ft.
Casing height above land surface 0 in. weight lbs./ft. Wall thickness or gauge No.

TYPE OF SCREEN OR PERFORATION MATERIAL:

1 Steel	3 Stainless steel	5 Fiberglass	7 PVC	10 Asbestos-cement
2 Brass	XX4 Galvanized steel	6 Concrete tile	8 RMP (SR)	11 Other (specify)
			9 ABS	12 None used (open hole)

SCREEN OR PERFORATION OPENINGS ARE:

1 Continuous slot	3 Mill slot	5 Gauzed wrapped	8 Saw cut	11 None (open hole)
2 Louvered shutter	4 Key punched	6 Wire wrapped	9 Drilled holes	
		7 Torch cut	10 Other (specify)	

SCREEN PERFORATED INTERVALS: From *N/A* to *N/A* ft. From to ft.

SCREEN-PERFORATED INTERVALS: From ft. to ft., From ft. to ft.
From ft. to ft., From ft. to ft.
GRAVEL PACK INTERVALS: From ft. to ft., From ft. to ft.
From ft. to ft., From ft. to ft.

6	GROUT MATERIAL:		1 Neat cement	XX	2 Cement grout	3 Bentonite	4 Other		
	Grout Intervals:	From	20	ft. to	2	ft. From	ft. to	ft. From	ft. to

What is the nearest source of possible contamination:

1 Septic tank	4 Lateral lines	7 Pit privy	10 Livestock pens	14 Abandoned water well
☒ Sewer lines	5 Cess pool	8 Sewage lagoon	11 Fuel storage	15 Oil well/Gas well
3 Watertight sewer lines	6 Seepage pit	9 Feedyard	12 Fertilizer storage	16 Other (specify below)
Direction from well? south			13 Insecticide storage	<i>NONE</i>
			How many feet?	

FROM	TO	LITHOLOGIC LOG	FROM	TO	PLUGGING INTERVALS
			Surface	to an	estimated 20 feet.
			20	2	CEMENT
			2	0	Clay
					DEC 1 3 1991

7 CONTRACTOR'S OR LANDOWNER'S CERTIFICATION: This water well was (1) constructed, (2) reconstructed, or (3) plugged under my jurisdiction and was completed on (mo/day/year) and this record is true to the best of my knowledge and belief. Kansas Water Well Contractor's License No. This Water Well Record was completed on (mo/day/yr) .. December 16, 1991 under the business name of by (signature) Dotti Brace City Clerk