WATER WELL RECORD Form WWC-5 KSA 82a-1212 PLUGGING REPORT

1 LOCATION OF WATER WELL: County: RENO	Fraction: SE ¼ SW ¼ SE ¼	Section Number: 18	Township Number: T 26 S	Range Number: R 6 E/W

Distance and direction from nearest town or city street address of well if located within city?
327 Plum, Pretty Prairie KS 67570

2 WATER WELL OWNER: Roger and Elaine McClure
RR#, St. Address, Box # : 327 Plum
City, State, ZIP Code : Pretty Prairie KS 67570
Board of Agriculture, Division of Water Resource
Application Number:

3 LOCATE WELL'S LOCATION WITH AN "X" IN SECTION BOX:

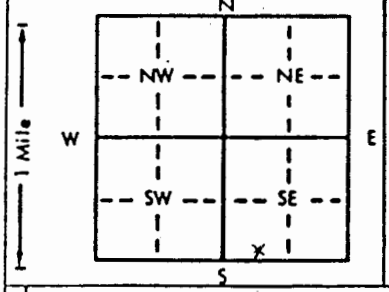

4 DEPTH OF COMPLETED WELL 14 ft. ELEVATION:
Depth(s) Groundwater Encountered 1. ft. 2. ft. 3. ft.
WELL'S STATIC WATER LEVEL 999 ft. below land surface measured on mo/day/yr 7/29/93
Pump test data: Well water was ft. after hours pumping gpm
Est. Yield gpm: Well water was ft. after hours pumping gpm
Bore Hole Diameter in. to ft., and in. to ft
WELL WATER TO BE USED AS: 1 Domestic 2 Irrigation 3 Feedlot 4 Industrial 5 Public water supply 6 Oil field water supply 7 Lawn and garden only 8 Air conditioning 9 Dewatering 10 Observation well 11 Injection well X 12 Other (Specify below) Inactive
Was a chemical/bacteriological sample submitted to Department? Yes No X; If yes, mo/day/yr sample was submitted
Water Well Disinfected? Yes X No

5 TYPE OF BLANK CASING USED: 1 Steel 2 PVC 3 RMP (SR) 4 ABS 5 Wrought iron 6 Asbestos-Cement 7 Fiberglass X 9 Other (specify below) GALVANIZED 8 Concrete tile
CASING JOINTS: Glued Clamped Welded Threaded
Blank casing diameter 5½ in. to ft., Dia in. to ft., Dia in. to ft
Casing height above land surface 72" below in., weight lbs./ft. Wall thickness or gauge No.
TYPE OF SCREEN OR PERFORATION MATERIAL: 1 Steel 2 Brass 3 Stainless steel 4 Galvanized steel 5 Fiberglass 6 Concrete tile 7 PVC 8 RMP (SR) 9 ABS 10 Asbestos-cement 11 Other (specify) N/A 12 None used (open hole)
SCREEN OR PERFORATION OPENINGS ARE: 1 Continuous slot 2 Louvered shutter 3 Mill slot 4 Key punched 5 Gauzed wrapped 6 Wire wrapped 7 Torch cut 8 Saw cut 9 Drilled holes 10 Other (specify) 11 None (open hole)
SCREEN-PERFORATED INTERVALS: From N/A ft. to N/A ft., From ft. to ft
From ft. to ft., From ft. to ft
GRAVEL PACK INTERVALS: From N/A ft. to N/A ft., From ft. to ft
From ft. to ft., From ft. to ft

6 GROUT MATERIAL: 1 Neat cement 2 Cement grout X 3 Bentonite 4 Other
Grout Intervals: From 14 ft. to 6'4" ft., From ft. to ft., From ft. to ft
What is the nearest source of possible contamination: 1 Septic tank 2 Sewer lines 3 Watertight sewer lines 4 Lateral lines 5 Cess pool 6 Seepage pit 7 Pit privy 8 Sewage lagoon 9 Feedyard 10 Livestock pens 11 Fuel storage 12 Fertilizer storage 13 Insecticide storage 14 Abandoned water well 15 Oil well/Gas well X 16 Other (specify below) HOUSE
Direction from well? north How many feet? 0

FROM	TO	LITHOLOGIC LOG	FROM	TO	LITHOLOGIC LOG
14'	6'4"	Bentonite			
6'4"	6'	Cement			
6'	0	Basement			

RECEIVED
AUG 03 1993
BUREAU OF WATER

7 CONTRACTOR'S OR LANDOWNER'S CITATION: This water well was [redacted] plugged under my jurisdiction and was completed on (mo/day/year) 7/29/93 and this record is true to the best of my knowledge and belief. Kansas Water Well Contractor's License No. This Water Well Record was completed on (mo/day/yr) 7/29/93 under the business name of ADVANCE TERMITE & PEST CONTROL, INC. by (signature) Terry Savoy Terry Savoy

INSTRUCTIONS: Use typewriter or ball point pen, *PLEASE PRESS FIRMLY* and *PRINT* clearly. Please fill in blanks, underline or circle the correct answers. Send top three copies to Kansas Department of Health and Environment, Division of Environment, Environmental Geology Section, Topeka, KS 66620. Send one to WATER WELL OWNER and retain one for your records.