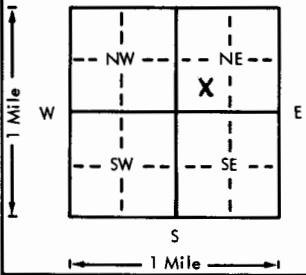


USE TYPEWRITER OR BALL
POINT PEN-PRESS FIRMLY,
PRINT CLEARLY.

WATER WELL RECORD
KSA 82a-1201-1215

Kansas Department of Health and
Environment-Division of Environment
(Water well Contractors)
Topeka, Kansas 66620

1. Location of well:		County RENO	Fraction 1/4 SW 1/4 NE 1/4	Section number 22	Township number T 26 S	Range number R 6 E
2. Distance and direction from nearest town or city: 3 E 1/2 S.		3. Owner of well: Abbott-Jones, INC				
Street address of well location if in city: Pretty Prairie, KS		R.R. or street: 830 SUTTON PL				
		City, state, zip code: Wichita, KS				
4. Locate with "X" in section below:		Sketch map:				6. Bore hole dia. 7 in. Completion date 11-11-75 Well depth 85 ft.
						7. Cable tool ☒ Rotary ☐ Driven ☐ Dug ☐ Hollow rod ☐ Jetted ☐ Bored ☐ Reverse rotary
5. Type and color of material		From	To	8. Use: ☐ Domestic ☐ Public supply ☐ Industry ☐ Irrigation ☐ Air conditioning ☐ Stock ☐ Lawn ☒ Oil field water ☐ Other		
Top Soil-clay		0	10	9. Casing: Material ☐ Height: Above or below Threaded ☐ Welded ☐ Surface 12 in. RMP ☐ PVC ☒ Weight ☐ lbs./ft. Dia. 4 in. to 85 ft. depth Wall Thickness: inches or Dia. ☐ in. to ☐ ft. depth gage No. ☐		
Sandy clay		10	25	10. Screen: Manufacturer's name MPI Type PVC Dia. 4" Slot/gauze 1/8" Length 40 Set between 45 ft. and 85 ft. ☐ ft. and ☐ ft.		
Sand-gravel-clay		25	85	Gravel pack? ☒ Size range of material 1/4 - 3/4"		
				11. Static water level: ☐ mo./day/yr. 30 ft. below land surface Date 11-11-75		
				12. Pumping level below land surfaces: ☐ ft. after ☐ hrs. pumping ☐ g.p.m. ☐ ft. after ☐ hrs. pumping ☐ g.p.m. Estimated maximum yield 40 g.p.m.		
				13. Water sample submitted: ☐ mo./day/yr. ☐ Yes ☒ No Date ☐		
				14. Well head completion: ☐ Pitless adapter 12 inches above grade		
				15. Well grouted? ☒ With: ☐ Neat cement ☒ Bentonite ☐ Concrete Depth: From 0 ft. to 10 ft.		
				16. Nearest source of possible contamination: 011 ft. 60 Direction SW Type Test Well disinfected upon completion? ☐ Yes ☒ No		
				17. Pump: ☒ Not installed Manufacturer's name ☐ Model number ☐ HP ☐ Volts ☐ Length of drop pipe ☐ ft. capacity ☐ g.p.m. Type: ☐ Submersible ☐ Turbine ☐ Jet ☐ Reciprocating ☐ Centrifugal ☐ Other		
		(Use a second sheet if needed)				
18. Elevation:	19. Remarks:					20. Water well contractor's certification: This well was drilled under my jurisdiction and this report is true to the best of my knowledge and belief. Kelly's Water Well Serv 186 Business name R2 Great Bend KS License No. 11-11-75 Address Kelly Price Date 11-11-75 Signed Kelly Price Authorized representative
Topography: ☐ Hill ☐ Slope ☒ Upland ☐ Valley						

Forward the white, blue and pink copies to the Department of Health and Environment

Form WWC-5