

WATER WELL RECORD


Form WWC-5

Division of Water Resources App. No.

1 LOCATION OF WATER WELL: County: Reno Fraction NW 1/4 SE 1/4 SE 1/4 SE 1/4 Section Number 13 Township No. T 26 S Range Number R 7 E W

Street/Rural Address of Well Location; if unknown, distance & direction from nearest town or intersection: If at owner's address, check here [] Global Positioning System (GPS) information: Latitude: .37,77876 Longitude: 098.02863 Elevation: 1564

2 WATER WELL OWNER: City of Pretty Prairie RR#, Street Address, Box #: 119 W. Main Street City, State, ZIP Code : Pretty Prairie, Kansas 67570

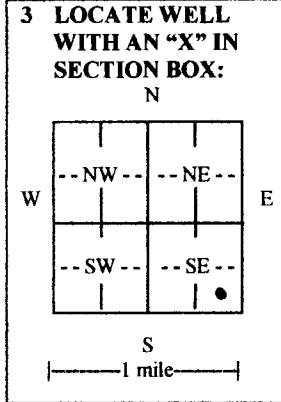

3 LOCATE WELL WITH AN 'X' IN SECTION BOX: 4 DEPTH OF COMPLETED WELL 67 ft. Depth(s) Groundwater Encountered (1)..... ft. (2)..... ft. (3)..... ft. WELL'S STATIC WATER LEVEL 22.54 ft. below land surface measured on mo/day/yr. 5/27/2015

5 TYPE OF CASING USED: [] Steel [X] PVC [] Other CASING JOINTS: [X] Glued [] Clamped [] Welded [] Threaded Casing diameter 2 in. to 57 ft., Diameter in. to ft., Diameter in. to ft. Casing height above land surface 36 in., Weight SCH40 lbs./ft., Wall thickness or gauge No. 154

6 GROUT MATERIAL: [] Neat cement [] Cement grout [X] Bentonite [] Other Grout Intervals: From 55 ft. to 1 1/2 ft., From ft. to ft., From ft. to ft. What is the nearest source of possible contamination: [] Septic tank [] Lateral lines [] Pit privy [] Livestock pens [] Insecticide storage [] Other (specify below)

Table with columns: FROM, TO, LITHOLOGIC LOG, FROM, TO, LITHO. LOG (cont.) or PLUGGING INTERVALS. Rows include: 0-2 Top soil, 2-12 Tan clay, 12-17 Light gray clay, 17-19 Coarse gravel, 19-30 Small-med. sand w/strks of clay, 30-35 Small sand w/ clay strks., 35-36 Clay, 36-66 Small-med.sand, 66-67 Red bed

7 CONTRACTOR'S OR LANDOWNER'S CERTIFICATION: This water well was [X] constructed, [] reconstructed, or [] plugged under my jurisdiction and was completed on (mo/day/year) 5/27/2015 and this record is true to the best of my knowledge and belief. Kansas Water Well Contractor's License No. 134 This Water Well Record was completed on (mo/day/year) 6/2/2015 under the business name of Rosencransantz-Bemis Ent. by (signature)

INSTRUCTIONS: Use typewriter or ball point pen. PLEASE PRESS FIRMLY and PRINT clearly. Please fill in blanks and check the correct answers. Send three copies (white, blue, pink) to Kansas Department of Health and Environment, Bureau of Water, Geology Section, 1000 SW Jackson St., Suite 420, Topeka, Kansas 66612-1367. Telephone 785-296-5524. Send one copy to WATER WELL OWNER and retain one for your records. Include fee of \$5.00 for each constructed well. Visit us at http://www.kdheks.gov/waterwell/index.html.