


(previously authorized) 42431

WATER WELL PLUGGING RECORD Form WWC-5P KSA 82a-1212 ID NO.

1 LOCATION OF WATER WELL: County: Reno Fraction: 1/4 NE 1/4 Section Number: 2 Township Number: T 26 S Range Number: 7 E W

Street/Rural Address of Well Location; if unknown, distance & direction from nearest town or intersection: If at owner's address, check here [ ] approximately 2.25 miles north and 1 miles west of Pretty Prairie, KS Global Positioning Systems (GPS) information: Latitude: 37.82011 Longitude: -98.04568 Elevation: Horizontal Datum: [ ] WGS84, [ ] NAD83, [X] NAD27 Collection Method: [X] GPS unit (Make/Model: Garmin GPSmap 60CSx) [ ] Digital Map/Photo, [ ] Topographic Map, [ ] Land Survey Est. Accuracy: [ ] < 3 m, [X] 3-5 m, [ ] 5-15 m, [ ] > 15 m

2 WATER WELL OWNER: A & A Bentson LLC RR#, St. Address, Box #: 1 Compound Dr City, State ZIP Code: Hutchinson, KS 67502

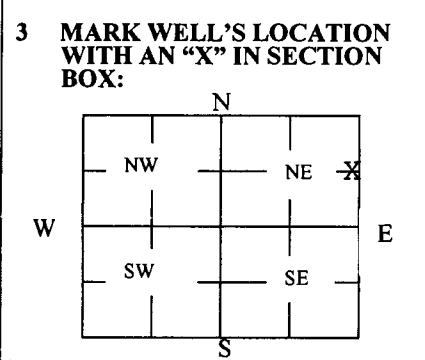

4 DEPTH OF WELL 93 ft. WELL'S STATIC WATER LEVEL 42.8 ft. WELL WAS USED AS: [X] Irrigation [ ] Domestic [ ] Public Water Supply [ ] Oil Field Water Supply [ ] Dewatering [ ] Feedlot [ ] Domestic (Lawn & Garden) [ ] Monitoring [ ] Industrial [ ] Air Conditioning [ ] Injection Well [ ] Other Was a chemical/bacteriological sample submitted to Department? Yes [ ] No [X]

5 TYPE OF BLANK CASING USED: [X] Steel PVC [ ] RMP (SR) ABS [ ] Wrought Asbestos-Cement [ ] Fiberglass Concrete Tile [ ] Other (Specify below) Blank casing diameter: 16 in. Was casing pulled? Yes [ ] No [X] If yes, how much Casing height above or below land surface below 36 in.

6 GROUT PLUG MATERIAL: [ ] Neat cement [X] Cement grout [ ] Bentonite [ ] Other Grout Plug Intervals: From 42.8 ft. to 3 ft., From ft. to ft., From ft. to ft. What is the nearest source of possible contamination: [ ] Septic tank [ ] Sewer lines [ ] Watertight sewer lines [ ] Lateral lines [ ] Cess pool [ ] Seepage pit [ ] Pit privy [ ] Sewage lagoon [ ] Feedyard [ ] Livestock pens [X] Fuel storage [ ] Fertilizer storage [ ] Insecticide storage [ ] Abandoned water well [ ] Oil well/Gas well [ ] Other (specify below) Direction from well? northeast How many feet? approximately 15 feet

Table with 6 columns: FROM, TO, PLUGGING MATERIALS, FROM, TO, PLUGGING MATERIALS. Row 1: 93, 42.8, Clean, coarse sand, Well plugging witnessed by. Row 2: 42.8, 3, Cement grout, D. Randolph, GMD2 staff on. Row 3: 3, 0, Topsoil, 4/12/17 and 4/13/17.

7 CONTRACTOR'S OR LANDOWNER'S CERTIFICATION: This water well was plugged under my jurisdiction and was completed on (mo/day/year) 4/13/2017 and this record is true to the best of my knowledge and belief. Kansas Water Well Contractor's License No. This Water Well Record was completed on (mo/day/year) 4/18/2017 under the business name of A & A BENTSON, LLC. by (signature) Ronald E. Selber

Send one white copy to Kansas Department of Health & Environment, Geology Section, 1000 SW Jackson Street, Ste. 420, Topeka, KS 66612-1367. Send one copy to WATER WELL OWNER and retain one for your records. Visit us at http://www.kdheks.gov/waterwell/index.html Telephone 785-296-5524. MAY 09 2017