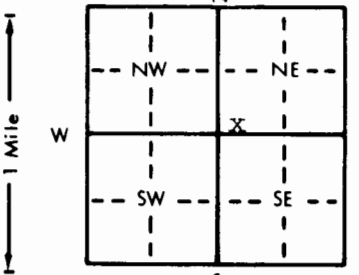


|   |  |   |                |                 |              |
|---|--|---|----------------|-----------------|--------------|
| 1 LOCATION OF WATER WELL:   |  | Fraction   | Section Number | Township Number | Range Number |
| County: Reno   |  | SW 1/4 SW 1/4 NE 1/4   | 3              | T 26S S         | R 7W E/W     |
| Distance and direction from nearest town or city street address of well if located within city?   |  |   |                |                 |              |
| 1/2 Mile North of Pretty Prairie, 1/2 mile West, and south into field.   |  |   |                |                 |              |
| 2 WATER WELL OWNER: Kirk Larson   |  |   |                |                 |              |
| RR#, St. Address, Box #: Rural Route #2   |  |   |                |                 |              |
| City, State, ZIP Code: Pretty Prairie, Kansas 67570   |  |   |                |                 |              |
| Board of Agriculture, Division of Water Resources   |  |   |                |                 |              |
| Application Number: 36,983   |  |   |                |                 |              |
| 3 LOCATE WELL'S LOCATION WITH AN "X" IN SECTION BOX:   |  | 4 DEPTH OF COMPLETED WELL: 47' ft. ELEVATION:   |                |                 |              |
|   |  | Depth(s) Groundwater Encountered 1. . . . . ft. 2. . . . . ft. 3. . . . . ft.                                                                                               |                |                 |              |
|   |  | WELL'S STATIC WATER LEVEL . . . . . ft. below land surface measured on mo/day/yr                                                                                            |                |                 |              |
|   |  | Pump test data: Well water was . . . . . ft. after . . . . . hours pumping . . . . . gpm                                                                                    |                |                 |              |
|   |  | Est. Yield . . . . . gpm: Well water was . . . . . ft. after . . . . . hours pumping . . . . . gpm                                                                          |                |                 |              |
|   |  | Bore Hole Diameter . . . 30 . . . in. to . . . . . ft., and . . . . . in. to . . . . . ft.                                                                                  |                |                 |              |
|   |  | WELL WATER TO BE USED AS: 5 Public water supply 8 Air conditioning 11 Injection well                                                                                        |                |                 |              |
|   |  | 1 Domestic 3 Feedlot 6 Oil field water supply 9 Dewatering 12 Other (Specify below)                                                                                         |                |                 |              |
|   |  | 2 Irrigation 4 Industrial 7 Lawn and garden only 10 Observation well   |                |                 |              |
|   |  | Was a chemical/bacteriological sample submitted to Department? Yes <input checked="" type="checkbox"/> No <input type="checkbox"/> ; If yes, mo/day/yr sample was submitted |                |                 |              |
|   |  | Water Well Disinfected? Yes HTH No   |                |                 |              |
| 5 TYPE OF BLANK CASING USED:   |  |   |                |                 |              |
| 1 Steel 3 RMP (SR) 5 Wrought iron 8 Concrete tile CASING JOINTS: Glued . . . . . Clamped . . . . .   |  |   |                |                 |              |
| 2 PVC 4 ABS 6 Asbestos-Cement 9 Other (specify below) Welded <input checked="" type="checkbox"/> . . . . .   |  |   |                |                 |              |
| Blank casing diameter . . . 16 . . . in. to . . . 27 . . . ft., Dia . . . . . in. to . . . . . ft., Dia . . . . . in. to . . . . . ft.   |  |   |                |                 |              |
| Casing height above land surface . . . 12 . . . in., weight . . . . . lbs./ft. Wall thickness or gauge No. <input checked="" type="checkbox"/> 1/4"   |  |   |                |                 |              |
| TYPE OF SCREEN OR PERFORATION MATERIAL:   |  |   |                |                 |              |
| 1 Steel 3 Stainless steel 5 Fiberglass 7 PVC 10 Asbestos-cement   |  |   |                |                 |              |
| 2 Brass 4 Galvanized steel 6 Concrete tile 8 RMP (SR) 11 Other (specify) . . . . .   |  |   |                |                 |              |
| SCREEN OR PERFORATION OPENINGS ARE:   |  |   |                |                 |              |
| 1 Continuous slot 3 Mill slot 5 Gauzed wrapped 8 Saw cut 11 None (open hole)   |  |   |                |                 |              |
| 2 Louvered shutter 4 Key punched 6 Wire wrapped 9 Drilled holes   |  |   |                |                 |              |
| 7 Torch cut 10 Other (specify) . . . . .   |  |   |                |                 |              |
| SCREEN-PERFORATED INTERVALS: From . . . 27 . . . ft. to . . . 47 . . . ft., From . . . . . ft. to . . . . . ft.   |  |   |                |                 |              |
| GRAVEL PACK INTERVALS: From . . . 10 . . . ft. to . . . 47 . . . ft., From . . . . . ft. to . . . . . ft.   |  |   |                |                 |              |
| 6 GROUT MATERIAL: 1 Neat cement 2 Cement grout 3 Bentonite 4 Other . . . . .   |  |   |                |                 |              |
| Grout Intervals: From . . . 0 . . . ft. to . . . 10 . . . ft., From . . . . . ft. to . . . . . ft., From . . . . . ft. to . . . . . ft.   |  |   |                |                 |              |
| What is the nearest source of possible contamination:   |  |   |                |                 |              |
| 1 Septic tank 4 Lateral lines 7 Pit privy 10 Livestock pens 14 Abandoned water well   |  |   |                |                 |              |
| 2 Sewer lines 5 Cess pool 8 Sewage lagoon 11 Fuel storage 15 Oil well/Gas well   |  |   |                |                 |              |
| 3 Watertight sewer lines 6 Seepage pit 9 Feedyard 12 Fertilizer storage 16 Other (specify below)   |  |   |                |                 |              |
| 13 Insecticide storage NONE   |  |   |                |                 |              |
| Direction from well? How many feet?   |  |   |                |                 |              |
| FROM   |  | TO   |                | LITHOLOGIC LOG  |              |
| 0   |  | 5   |                | Top Soil & Sand |              |
| 5   |  | 26   |                | Clay            |              |
| 26   |  | 47   |                | Medium Sand     |              |
| 7 CONTRACTOR'S OR LANDOWNER'S CERTIFICATION: This water well was (1) constructed, (2) reconstructed, or (3) plugged under my jurisdiction and was completed on (mo/day/year) . . . May 21, 1984 . . . and this record is true to the best of my knowledge and belief. Kansas Water Well Contractor's License No. . . . #134 . . . This Water Well Record was completed on (mo/day/yr) . . . May 22, 1984 . . . under the business name of Rosencrantz-Bemis Enterprises by (signature) Harry J. Mannetarker |  |   |                |                 |              |
| INSTRUCTIONS: Use typewriter or ball point pen, PLEASE PRESS FIRMLY and PRINT clearly. Please fill in blanks, underline or circle the correct answers. Send top three copies to Kansas Department of Health and Environment, Division of Environment, Environmental Geology Section, Topeka, KS 66620. Send one to WATER WELL OWNER and retain one for your records.   |  |   |                |                 |              |