

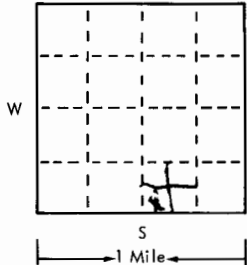
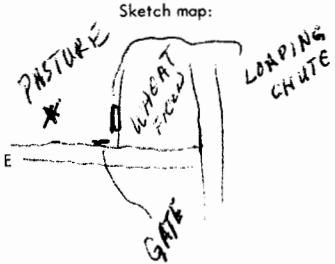
USE TYPEWRITER OR BALL
POINT PEN-PRESS FIRMLY,
PRINT CLEARLY.

WATER WELL RECORD
KSA 82a-1201-1215

26 7W 19 SW 1/4 SE 1/4

T R EW sec 1/4 1/4 1/4 No.

Kansas State Dept. Of Health
(Water Well Contractors)
Forbes-Bldg. 740
Topeka, Kansas 66620

1 Location of well:	County Reno	Township name Roscoe	Fraction SW 1/4 SW 1/4 SE 1/4	Section number 19	Town number 26	Range number 7W			
Distance and direction from nearest town or city: Pretty Prairie, Kansas Street address of well location if in city:				3 Owner of well: Emmett Hutton Address: Rt. 1 Kingman, Kansas					
Locate with "X" in section below: N  W S 1 Mile				Sketch map: 		4 Well depth: 60' ft. Date of completion 5-20-76 Well diameter 12" in. 30' 8" 30'			
2 Type and color of material				From	To	5 ☐ Cable tool ☒ Rotary ☐ Driven ☐ Dug ☐ Hollow rod ☐ Jetted ☐ Bored ☐ Reverse rotary			
				6 Use: ☒ Domestic ☐ Public supply ☐ Industry ☐ Irrigation ☐ Air conditioning ☐ Commercial ☐ Test well ☐					
				7 Casing: Material RMB Height: above/below Threaded ☐ Welded ☐ Surface 13 in. Diam. 6 in. to 60 ft. depth Drive shoe? ☐ Yes ☒ No in. to ft. depth					
				8 Screen: Manufacturer Jesse & Lowe Type Slotted Dia. 6" Slot/gauze 1/16" Length 20' Set between 40 ft. and 60 ft. Fittings: Gravel pack ☒ Yes ☐ No Size range of material					
				9 Static water level: 21 ft. below land surface Date 5-20					
top soil				0	4'	10 Pumping level below land surfaces: 28 ft. after 1 hrs. pumping 400 g.p.m. ft. after hrs. pumping g.p.m. Estimated maximum yield 900 g.p.m.			
tan Clay				4	15	11 Water sample submitted: ☒ Yes ☐ No Date 5-16			
fine sand				15	23	12 Well head completion: Capped adapter ☐ Inches above grade			
coarser sand				23	30	13 Well grouted? ☒ Yes ☐ No ☒ Neat cement ☐ Bentonite Depth: From 13 ft. to 3 ft.			
red bed shale w/ thin streaks of				30	60	14 Nearest source of possible contamination: ft. Pond Direction West Type 1/8 mi. Well disinfected upon completion? ☒ Yes ☐ No			
blue clay & blue shale w/ fractures						15 Pump: ☒ Not installed Manufacturer's name Model number HP Volts Length of drop pipe ft. capacity g.p.m. Type: ☐ Submersible ☐ Turbine ☐ Jet ☐ Reciprocating ☐ Centrifugal ☐ Other			
containing small amount of water.						16 Remarks: elevation Customer to run slab. Topography: ☐ Hill ☐ Slope ☒ Upland ☐ Valley			
(use a second sheet if needed)						17 Water well contractor's certification: This well was drilled under my jurisdiction and this report is true to the best of my knowledge and belief. McLean Drilling Co. Business name License No. 227 Address 3B3 Signed Billy J. McLean Date 6-10-76 Authorized representative			

Forward the white, blue and pink copies to the Kansas State Dept. Of Health.

Form WWC-5