WATER WELL PLUGGING RECORD Form WWC-5P KSA 82a-1212

1 LOCATION OF WATER WELL: County: Reno	Fraction: Near Ctr SW 1/4 NE 1/4 SW 1/4	Section Number: 2	Township Number: 26	Range Number: 7W

Distance and direction from nearest town or city street address of well if located within city?
1500 ft. North & 3820 ft. West of Southeast Section Corner

2 WATER WELL OWNER: Charles and Joan Bentson
RR#, St. Address, Box #: 205 W. 29th
City, State, ZIP Code : Hutchinson, KS 67502

Board of Agriculture, Division of Water Resources Application Number: 38780

3 MARK WELL'S LOCATION WITH AN "X" IN SECTION BOX:

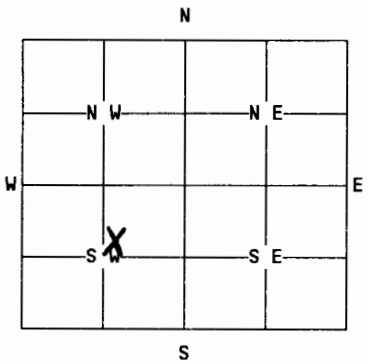

4 DEPTH OF WELL 79 ft.
WELL'S STATIC WATER LEVEL 39 ft.

WELL WAS USED AS:

1 Domestic 5 Public Water Supply 9 Dewatering
(2 Irrigation) 6 Oil Field Water Supply 10 Monitoring Well
3 Feedlot 7 Lawn and Garden Only 11 Injection Well
4 Industrial 8 Air Conditioning 12 Other.....

Was a chemical/bacteriological sample submitted to Department? Yes.... No X
If yes, mo/day/yr sample was submitted.....

Water Well Disinfected: Yes X No.....

5 TYPE OF BLANK CASING USED:

1 Steel 3 RMP (SR) 5 Wrought 7 Fiberglass 9 Other (specify below)
(2 PVC) 4 ABS 6 Asbestos-Cement 8 Concrete Tile .....

Blank casing diameter 16 in. Was casing pulled? Yes..... No. X If yes, how much.....
Casing height ~~above~~ or (below) land surface 3.6 in.

6 GROUT PLUG MATERIAL: 1 Neat cement (2 Cement grout) 3 Bentonite 4 Other.....

Grout Plug Intervals: From 39 ft. to 3 ft., From.....ft. to .....ft., From..... to.....ft.

What is the nearest source of possible contamination:

1 Septic tank 6 Seepage pit 11 Fuel storage 16 Other (specify below)
2 Sewer lines 7 Pit privy 12 Fertilizer storage .....
3 Watertight sewer lines 8 Sewage lagoon 13 Insecticide storage
4 Lateral lines 9 Feedyard 14 Abandoned water well
5 Cess Pool (10 Livestock pens) 15 Oil well/Gas well

Direction from well? Southeast How many feet? 1700

FROM	TO	PLUGGING MATERIALS
79	39	Sand & Gravel
39	3	Cement Grout
3	0	Topsoil

* East Well of 2 wells Plugged.

OCT 28 1994

7 CONTRACTOR'S OR LANDOWNER'S CERTIFICATION: This water well was plugged under my jurisdiction and was completed on (mo/day/year) 10-14-94 and this record is true to the best of my knowledge and belief. Kansas Water Well Contractor's License No. N/A. This Water Well Record was completed on (mo/day/year) 10-17-94 under the business name of N/A
by (signature) Charles K. Bentson Joan Bentson

INSTRUCTIONS: Use typewriter or ball point pen. Please press firmly and print clearly. Please fill in blanks, underline or circle the correct answers. Send top three copies to Kansas Department of Health and Environment, Bureau of Water, Topeka, Kansas 66620-0001. Telephone: 913/296-3565. Send one to Water Well Owner and retain one for your records.